



FORM 202-B Ellis KANSAS ✓

Sec. 16 Twp. 15 R. 19W

Well No. 1 Hauschild Farm

Musgrove Petroleum Company

Musgrove - Contr. Contractor

Wildcat


330 Ft. from N. Line

Ft. from S. Line

330 Ft. from E. Line

Ft. from W. Line

NE NE SW

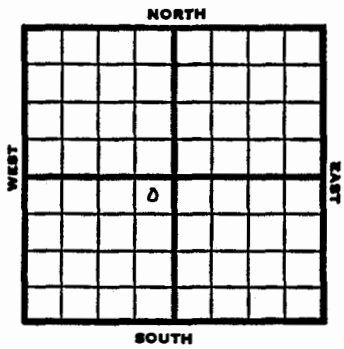


FORM 51 Ellis KANSAS

Section 16 Township 15 Range 19W

Well No. 1 Hauschild

Company Musgrove Petroleum Company

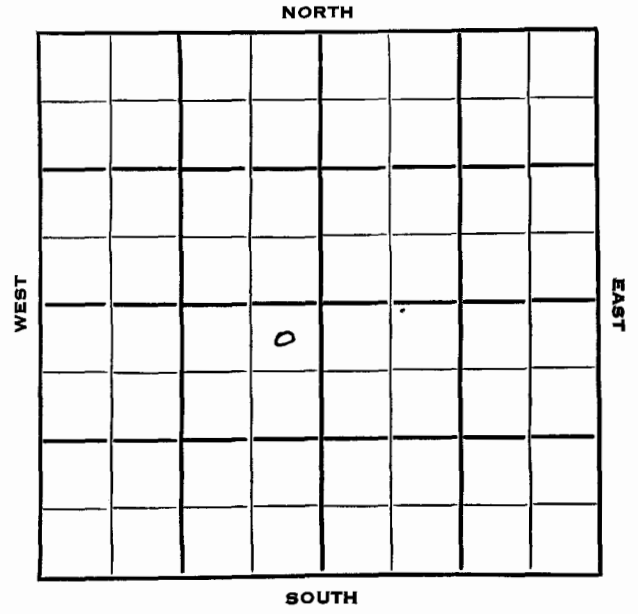

1953 Elev. 2010' REPORT

1/7 Spudding Date 1/5/53 Drlg. 608

1/23 Spud 1-5-53  
 D&A  
 TD 3639  
 8" @ 974  
 Heeb 3260, or 3281, Lans 3302,  
 Arb. 3608  
 DST 3610-18, opn 1 hr., rec.  
 10' mud  
 DST 3610-34, opn 1 hr., rec.  
 12' mud, 70#  
 Regan 3614, Granite 3639,  
 TD 3639  
 D&A

**ABANDONED**