

Map No. _____ Sec. 17 Twp. 15 R. 19WWell No. 1 Hauschild

_____ Bridgeport _____ Company

_____ FIRST REPORT _____ Contractor


SE/C

SECTION PLAT

_____ Ft. from N. Line

380 Ft. from S. Line330 Ft. from E. Line

_____ Ft. from W. Line

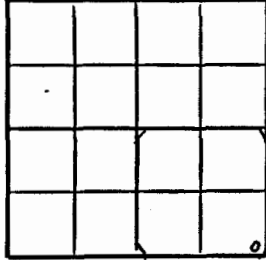

Ellis County

Location _____

Rig up _____

Drilling and Remarks:

8" @ 1210

drlg. 1925

RECORD

Cased _____ in. _____ ft.

Sand _____

Gas _____

Oil _____

Total Depth _____

PRODUCTION

1st 24 hrs. Nat. _____

1st 24 hrs. after shot _____

Gas _____ Cu. Ft.

Dry Hole _____

Abandoned _____

Date .

NOV 5 1947

19

S. J. LEWIS

Scout

Map No. 75 Sec. 17 Twp. 15 R. 19WWell No. 1 Hauschild

_____ Bridgeport _____ Company

_____ ABANDONED _____ Contractor


SE/C

SECTION PLAT

_____ Ft. from N. Line

380 Ft. from S. Line330 Ft. from E. Line

_____ Ft. from W. Line

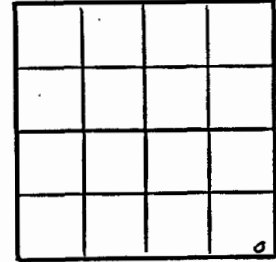

Ellis County

Location _____

Rig up _____

Drilling and Remarks:

*Reagan 1882.
5-12-583*

RECORD

Cased _____ in. _____ ft.

Sand _____

Gas _____

Oil _____

Total Depth 2647

PRODUCTION

1st 24 hrs. Nat. _____

1st 24 hrs. after shot _____

Gas _____ Cu. Ft.

Dry Hole _____

Abandoned _____

Date

DEC 3 1947

19

S. J. LEWIS

Scout

Ellis

KANSAS

15

19W

Sec. 17 Twp. 15 R. 19W

Well No. #1 Hauschild Farm
Bridgeport

Company

Penny Wann

Ft. from N. Line

380


Ft. from S. Line

330

Ft. from E. Line

Ft. from W. Line

SE/C

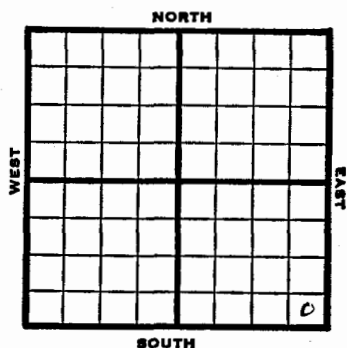

Elev. 1977' REPORT

~~1947~~

11/5

8" @ 1210

Drlg. 1925

11/12

Lansing 3258'

Drlg. 3264'

11/19

Reagan 3582'

TD 3592'

5" @ 3583'

RUST

11/25

5 bailers oil PH - 5 hrs.

12/3

Reagan 3582'

5" @ 3583'

Total Depth 3607'

ABANDONED

KANSAS

Ellis


Section 17 Township 15 Range 19W

Well No. 1 Hauschild

Company Bridgeport

Penny Wann

NORTH

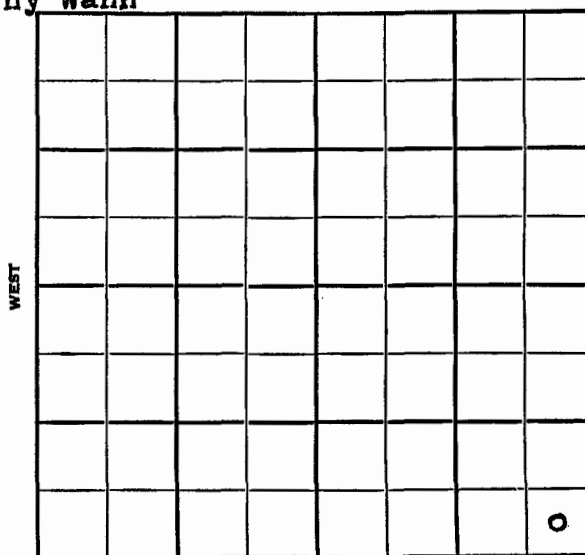

SOUTH