

Map No. _____ Sec. 18 Twp. 15 R. 19W

Well No. 1 Penny

Stickel Drlg. etal. Company

FIRST REPORT Contractor

NE NW


SECTION PLAT

330 Ft. from N. Line

Ft. from S. Line

330 Ft. from E. Line

Ft. from W. Line

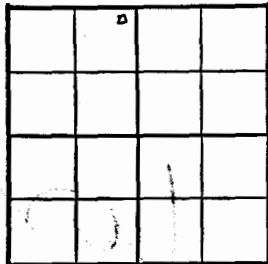

Ellis County

Location	RECORD	
	Cased	in., ft.
Rig up	Sand	
Drilling and Remarks:	Gas	
	Oil	
	Total Depth	
	PRODUCTION	
R U R	1st 24 hrs. Nat.	
	1st 24 hrs. after shot	
	Gas	Cu. Ft.
	Dry Hole	
	Abandoned	

Date

SEP 3 1947 19 S. J. LEWIS Scout

Map No. 75 Sec. 18 Twp. 15 R. 19W

Well No. 1 Penny

Stickel Drlg. etal. Company

ABANDONED Contractor

NE NW


E1,2009
SECTION PLAT

330 Ft. from N. Line

Ft. from S. Line

330 Ft. from E. Line

Ft. from W. Line

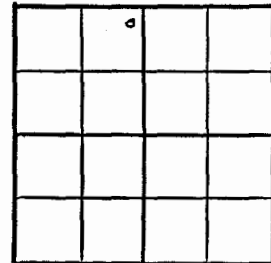

Ellis County

Location	RECORD	
	Cased	in., ft.
Rig up	Sand	
Drilling and Remarks:	Gas	
	Oil	
	Total Depth	3600
	PRODUCTION	
Same 3305 Reagan 3640	1st 24 hrs. Nat.	
	1st 24 hrs. after shot	
	Gas	Cu. Ft.
	Dry Hole	
	Abandoned	

Date

SEP 2 4 1947 19 S. J. LEWIS Scout

Ellis

Sec. 18 ^{KANSAS} Twp. 15 R. 19-W

Well No. 1 Penny Farm
Stickel Drlg. et al Company

Penny-Wann


330 Ft. from N. Line

 Ft. from S. Line

330 Ft. from E. Line

 Ft. from W. Line

NE NW

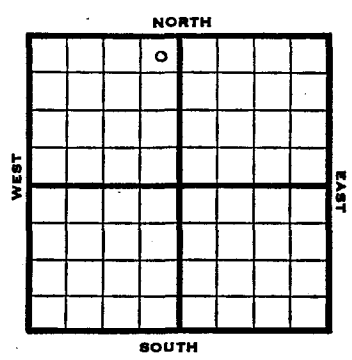

1947	Elev. 2009'	REPORT
9/3	RUR	
9/10	8" @ 1247'	
	Drlg. 1568'	
9/17	Topeka 3019'	
	Lansing 3305'	
	Drlg. 3337'	
9/24	Lans. 3305'	
	Reagan 3640'	
	TD 3650'	
	ABANDONED	

KANSAS

Ellis

Section 18 Township 15 Range 19W

Well No. 1 Penny

Company Stickel Drlg. et al

