

Sec. 19 Twp. 15 R. 19W

Well No. #1 Werth Farm

D.R. Lauck Oil Company

Lauck Contractor

Wildcat


Ft. from N. Line

330 Ft. from S. Line

330 Ft. from E. Line

Ft. from W. Line

SE SE SE Texas Support

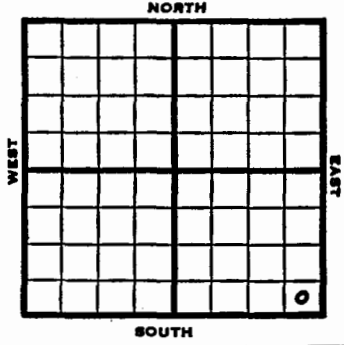


Section 19 Township 15 Range 19 W

Well No. # 1 Werth

Company D. R. Lauck Oil

NORTH

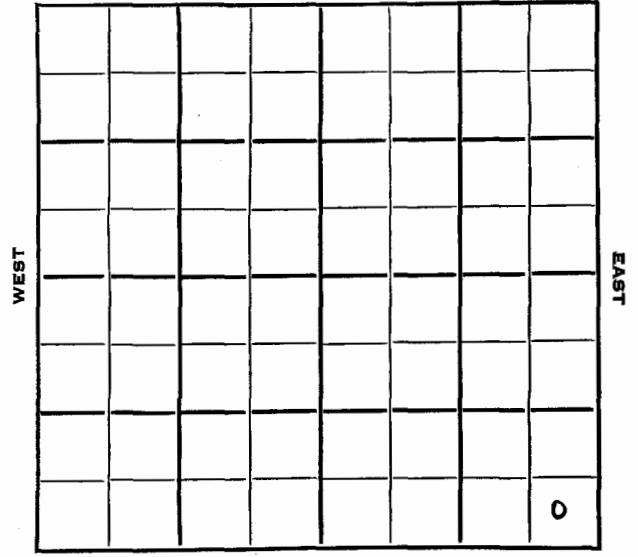

SOUTH

1953 Elev. 2057' REPORT

5/27 Spud 5-24-53

6/3 8" @ 960'
Anhy 1285'
Drlg 3225'

6/10 Spud 5-24-53
D & A
TD 3747'
8" @ 960'
Anhy 1285, Heeb 3327, Lans 3372, B KC
3602, Warm 3630', Cong 3687, Regan
3733
TD 3747'
D & A

ABANDONED