FORM 513 SUNRAY

County Saline Elev.
Sec. 5 Twp. 15 Rge. 2W
Company Deweese & Sanderson
Farm Name Sudenorf No. 1

TOPS	DEPTH	LOG	DATUM
Anh.			
Tp.			
H.			
Tr.			
Dg.			
Bl.			
L.			
K.C.			
B.K.C.			
Ce.			
C.			
M.			
M.			
K.			
Mz.			
Mc.			
V.			
S.			
S.			
A			
R.			
P€.			
G.			
T.D.			

Loc. in Sec. NE NW SE
Geol.
Contr. Greenland Tools
Pool Saline

AUG 21 '57
FIRST REPORT

Date Comm. 8-19-57
8" @ 247, WOC

Co. No. Sec. T. R.

FORM 513 SUNRAY

County Saline Elev. 1278 DF
Sec. 5 Twp. 15 Rge. 2W
Company Deweese & Sanderson
Farm Name Sudenorf No. 1

TOPS	DEPTH	LOG	DATUM
Anh.			
Tp.			
H.			
Tr.			
Dg.			
Bl.			
L.			
K.C.			
B.K.C.			
Ce.			
C.			
M.	2670		
M.			
K.			
Mz.			
Mc.			
K Dol	3259		
Sh Lio	3296		
S. S	3392		
A			
R.			
P€.			
G.			
T.D.	3430		

Loc. in Sec. NE NW SE
Geol.
Contr. Greenland Tools
Pool Saline

ABANDONED
SEP 18 '57

Date Comm. 8-19-57
8" @ 247, WOC AUG 28 57 D 2840 SEP 4 57
SEP 1 1 57 SEP 18 57

DEA (hold)

Co. No. Sec. T. R.


Saline KANSAS

SECTION 5 TOWNSHIP 15 S RANGE 2 W

WELL NO. # 1 Sudenorf

COMPANY DeWeese & Sanderson

NE NW SE

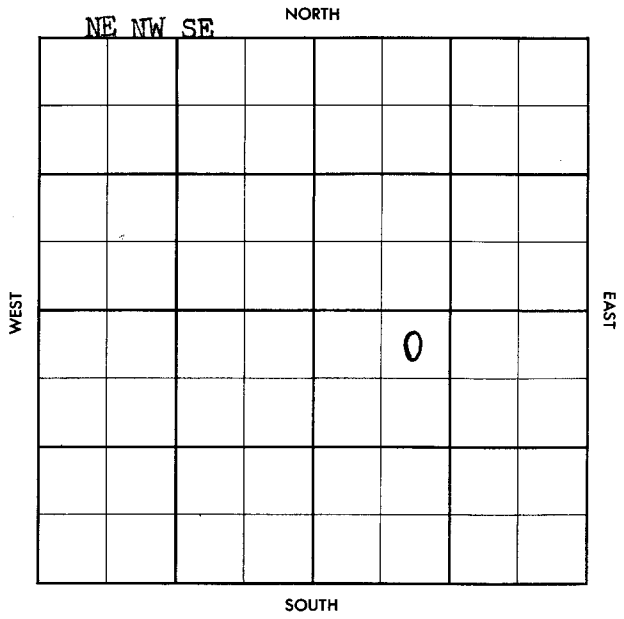

FORM 504-3 SUNRAY