

KANSAS

Pool Name Wildcat

Pool Name Wildcat

Map No. 42 Sec. 10 Twp. 15 R. 2W

Map No. 42 Sec. 10 Twp. 15 R. 2W

Well No. 2 Reiff

Well No. 2 Reiff

Ingling Etal Company

Ingling etal Company

**FIRST REPORT** Contractor

**ABANDONED** Contractor

C S L SW SE

SECTION PLAT

C S L SW SE

SECTION PLAT

\_\_\_\_\_ Ft. from N. Line

\_\_\_\_\_ Ft. from N. Line

330 Ft. from S. Line

330 Ft. from S. Line

\_\_\_\_\_ Ft. from E. Line

\_\_\_\_\_ Ft. from E. Line

660 Ft. from W. Line

660 Ft. from W. Line

Saline

Saline

Location \_\_\_\_\_

Location \_\_\_\_\_

Rig up \_\_\_\_\_

Rig up \_\_\_\_\_

Drilling and Remarks:

Drilling and Remarks:

R U R

Lane 287  
Alia 2825

**RECORD**

Cased \_\_\_\_\_ in, \_\_\_\_\_ ft.

Sand \_\_\_\_\_

Gas \_\_\_\_\_

Oil \_\_\_\_\_

Total Depth \_\_\_\_\_

**RECORD**

Cased \_\_\_\_\_ in, \_\_\_\_\_ ft.

Sand \_\_\_\_\_

Gas \_\_\_\_\_

Oil \_\_\_\_\_

Total Depth 2860

**PRODUCTION**

1st 24 hrs. Nat. \_\_\_\_\_

1st 24 hrs. after shot \_\_\_\_\_

Gas \_\_\_\_\_ Cu. Ft.

Dry Hole \_\_\_\_\_

Abandoned \_\_\_\_\_

**PRODUCTION**

1st 24 hrs. Nat. \_\_\_\_\_

1st 24 hrs. after shot \_\_\_\_\_

Gas \_\_\_\_\_ Cu. Ft.

Dry Hole €

Abandoned \_\_\_\_\_

Date

Date

JAN 31 1945 19 \_\_\_\_\_ S. J. LEWIS Scout

FEB 28 1945 19 \_\_\_\_\_ S. J. LEWIS Scout

KANSAS

Saline

Sec. 10 Twp. 15 R. 2W

Well No. #2 Reiff Farm

Ingling et al Company

Wildcat

Ft. from N. Line

330 Ft. from S. Line

Ft. from E. Line


660 Ft. from W. Line

C S L SW SE Elev. 1374

REPORT

|      |                    |
|------|--------------------|
| 1945 |                    |
| 1/31 | R U R              |
| 2/7  | 8" @ 145 WOC       |
| 2/14 | Drlg 1700 SD       |
| 2/21 | Drlg 2000          |
| 2/28 | Lans 2187          |
|      | Miss 2825          |
|      | TD <del>2860</del> |

ABANDONED

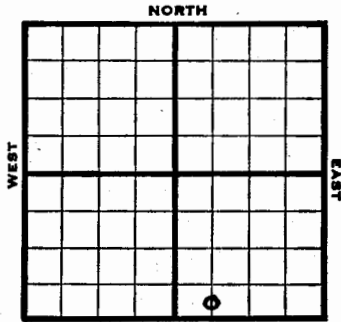

KANSAS

Saline

Section 10 Township 15 Range 2W

Well No. #2 Reiff

Company Ingling et al

