

Pool Name WildcatMap No. 42 Sec. 11 Twp. 15 R. 2WWell No. 1 RitterJackson et al.

Company

FIRST REPORT

Contractor

C S L SW NE

SECTION PLAT

		o	

Ft. from N. Line

330

Ft. from S. Line

Ft. from E. Line

660

Ft. from W. Line

Saline County

Location

Rig up

Drilling and Remarks:

Cellar

RECORD

Cased in, ft.

Sand

Gas

Oil

Total Depth

PRODUCTION

1st 24 hrs. Nat.

1st 24 hrs. after shot

Gas Cu. Ft.

Dry Hole

Abandoned

Date

AUG 2 1944

19

S. J. LEWIS

Scout

Pool Name WildcatMap No. 42 Sec. 11 Twp. 15 R. 2WWell No. 1 RitterDaley Morris et al.

Company

CORRECTION

Contractor

C S L SW NE

SECTION PLAT

		o	

Ft. from N. Line

330

Ft. from S. Line

Ft. from E. Line

660

Ft. from W. Line

Saline County

Location

Rig up

Drilling and Remarks:

ReportedJackson et al.

RECORD

Cased in, ft.

Sand

Gas

Oil

Total Depth

PRODUCTION

1st 24 hrs. Nat.

1st 24 hrs. after shot

Gas Cu. Ft.

Dry Hole

Abandoned

Date

AUG 9 1944

19

S. J. LEWIS

Scout

Pool Name WildcatMap No. 42 Sec. 11 Twp. 15 R. 2WWell No. 1 RitterDaley Morris etal. CompanyABANDONED

Contractor

C S L SW NE

SECTION PLAT

 Ft. from N. Line330 Ft. from S. Line Ft. from E. Line660 Ft. from W. LineSaline CountyLocation Rig up

Drilling and Remarks:

Miss 2749

RECORD

Cased in. ft.Sand Gas Oil Total Depth 2789

PRODUCTION

1st 24 hrs. Nat 1st 24 hrs. after shot Gas Cu. Ft.Dry Hole Abandoned

Date

AUG 23 1944

19

S. J. LEWIS

Scout

Saline

Sec. 11 Twp. 15 R. 2W
Well No. #1 Ritter Farm
Daley Morris et al
Jackson et al Company


Wildcat

 Ft. from N. Line

330 Ft. from S. Line

 Ft. from E. Line

660 Ft. from W. Line

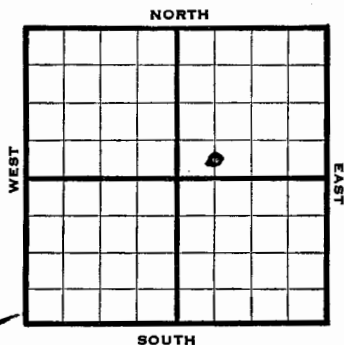

El ev. 1285

1944 REPORT

8/2 Cellar
8/9 10" @ 160 Drlg. 975
8/16 Lans. 2097
Drlg. 2722
8/23 Miss 2749
TD 2789

ABANDONED

KANSAS

Saline

Section 11 Township 15 Range 2W

Well No. #1 Ritter

Daley Morris et al
Jackson et al Company

