

Norman

Map No. KANSAS Sec. 17 Twp. 15 R. 24Well No. 1 ShairMentor Oil & Gas Company

Contractor

SECTION PLAT

----- Ft. from N. Line

330 Ft. from S. Line

----- Ft. from E. Line

330 Ft. from W. Line

FIRST REPORTS

Location -----

Rig up -----

Drilling and Remarks:

Rig

RECORD

Cased ----- in., ----- ft.

Sand -----

Gas -----

Oil -----

Total Depth -----

PRODUCTION

1st 24 hrs. Nat. -----

1st 24 hrs. after shot -----

Gas ----- Cu. Ft.

Dry Hole -----

Abandoned -----

Date

AUG 24 1940S. J. LEWIS Scout

no map

Map No. KANSAS Sec. 17 Twp. 15 R. 24Well No. 1 ShairMentor Oil & Gas Company

Contractor

SECTION PLAT

----- Ft. from N. Line

330 Ft. from S. Line

----- Ft. from E. Line

330 Ft. from W. Line**ABANDONED**

Location -----

Rig up -----

Drilling and Remarks:

TJ 3501J & H.

RECORD

Cased ----- in., ----- ft.

Sand -----

Gas -----

Oil -----

Total Depth -----

PRODUCTION

1st 24 hrs. Nat. -----

1st 24 hrs. after shot -----

Gas ----- Cu. Ft.

Dry Hole -----

Abandoned -----

Date

FEB 15 1928S. J. LEWIS

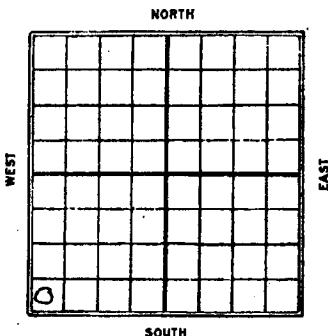
Scout

Map No. KANSAS Sec. 17 Twp. 15 R. 2WWell No. 1-Union FarmMentor oil & Gas Company

_____ Ft. from N. Line

330 Ft. from S. Line

_____ Ft. from E. Line

330 Ft. from W. Line

1/18 - T.D. 3205 - fishing 6"
 1/25 - Drly 3445 -
 1/31 - T.D. 3501 - S.D.
 2/15 - T.D. 3501 - D. & A.

1927

Date	REPORT
8/24	Log
8/31	
9/7	
9/14	Spud
9/24	Drly 320
9/28	" 675
10/5	" 1155
10/12	" 1750
10/19	" 2120
10/26	" 2130 - 8" @ 2065-
11/2	T.D. 2235 - U.R. 8"
11/9	T.D. 2308 - U.R. 8"
11/16	Drly 2450
11/22	" 2682
11/29	T.D. 2695 - U.R. 8"
12/7	
12/14	Drly 2735-
12/21	Top Chat 2760 - H.F.W. 2791 - drilling 2815-
12/28	Drly 3030-
1928	
1/4	U.R. 6" - 3170
1/11	T.D. 3205 - U.R. 6"

