

County Saline State Kansas
 Sec. 26 (Blk. Twp.) 15 (Sur. Rge.) 2W Map No.
 Operator W. R. White etal.
 Well No. 1 Farm Ekstrom
 Elev. _____ Location NW NW NW

0				

330 Ft. From N Line NW
330 Ft. From W Line Quarter
 Ist. Report JAN 23 1952
 Completion _____
 Remarks _____
 Spudding Date 1-17-52

Drig. Data Wildcat
8" @ 126' Drig. 1925

J. E. TYRA

County Saline State Kansas
 Sec. 26 (Blk. Twp.) 15 (Sur. Rge.) 2W Map No.
 Operator W. R. White etal.
 Well No. 1 Farm Ekstrom
 Elev. 1336 Location NW NW NW

0				

330 Ft. From N Line NW
330 Ft. From W Line Quarter
 Ist. Report _____
 Completion FEB 20 1952
 Remarks Wildcat
 Spudding Date 1-17-52

Drig. Data D & A TD 2817
8" @ 126 Lans. 2137 KC 2300
E KC 2458 Cherokee 2660 Brugess 2764
Burgess sd. 2771-83 5" @ 2775
CO to 2783 20/ 2775-83 Miss. 2810
TD 2817 N/S

D & A

J. G. McGEHEE

Saline

KANSAS

Sec. 26 Twp. 15 R. 2W

Well No. #1 Ekstrom Farm

W. R. White et al Company

Contractor


330 Ft. from N. Line

_____ Ft. from S. Line

_____ Ft. from E. Line

330 Ft. from W. Line

NW NW NW

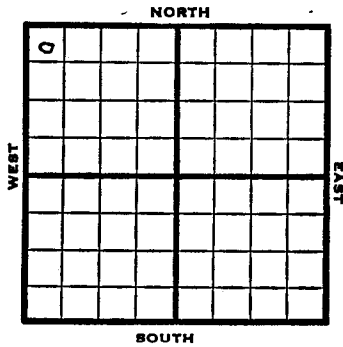

1952 Elev. 1336' REPORT

1/23 Spud 1-17-52
8" @ 126'
Drlg. 1925

2/6 D. plugs

2/13 CO to 2783 20/2775-83
DD got wtr Miss 2810
TD 2812

2/20 Spud 1-17-52
D&A TD 2817
8" @ 126 Lans. 2137 KC 2300
BKC 2458 Cherokee 2660
Burgess 2764 Burgess sd 2771-83
5" @ 2775 CO to 2783
20/2775-83 Miss 2810
TD 2817 N/S D&A

ABANDONED

KANSAS

Section 26 Township 15 Range 2W

Well No. #1 Ekstrom

Company W. R. White et al

