

Saline  
Map No. ~~KANSAS~~ Sec. 26 Twp. 15 R. 2W  
Well No. #1 Shelton  
Brown & Woodard Company

Contractor

FIRST REPORT

SECTION PLAT

			0

..... Ft. from N. Line  
200 Ft. from S. Line  
200 Ft. from E. Line  
..... Ft. from W. Line

Location .....  
Rig up .....  
Drilling and Remarks:

Rig & tools

RECORD

Cased..... in., ..... ft.  
Sand .....  
Gas .....  
Oil .....  
Total Depth.....

PRODUCTION

1st 24 hrs. Nat. ....  
1st 24 hrs. after shot.....  
Gas..... Cu. Ft.  
Dry Hole.....  
Abandoned.....

Date  
NOV 19 1924

M. A. BENEAR

..... 192..... Scout

Saline  
Map No. ~~KANSAS~~ Sec. 26 Twp. 15 R. 2W  
Well No. 1 Shelton  
Brown & Woodard Company

Contractor

SECTION PLAT

			0

..... Ft. from N. Line  
200 Ft. from S. Line  
200 Ft. from E. Line  
..... Ft. from W. Line

Correction

Location .....  
Rig up .....  
Drilling and Remarks:

12953441

Dasigne & Co  
has taken  
this over.

RECORD

Cased..... in., ..... ft.  
Sand .....  
Gas .....  
Oil .....  
Total Depth.....

PRODUCTION

1st 24 hrs. Nat. ....  
1st 24 hrs. after shot.....  
Gas..... Cu. Ft.  
Dry Hole.....  
Abandoned.....

Date  
JUN 16 1926

S. J. LEWIS

..... 192..... Scout

MAP No. \_\_\_\_\_ SEC. 26 TWP. 15S R. 2W

Map No. \_\_\_\_\_ Sec. 26 Twp. 15 R. 2W

WELL No. 1 Shelton

Well No. 1 Shelton

Dawson & S. COMPANY

Hanciger & Co. Company

CONTRACTOR

CONTRACTOR

SECTION PLAT

			0

\_\_\_\_\_ Ft. FROM N. LINE

\_\_\_\_\_ Ft. FROM S. LINE

\_\_\_\_\_ Ft. FROM E. LINE

\_\_\_\_\_ Ft. FROM W. LINE

SECTION PLAT

			0

\_\_\_\_\_ Ft. from N. Line

200 Ft. from S. Line

200 Ft. from E. Line

\_\_\_\_\_ Ft. from W. Line

**ABANDONED**

LOCATION \_\_\_\_\_

RIG UP \_\_\_\_\_

DRILLING AND REMARKS:

*plugged  
OK with  
on wall  
any*

RECORD

CASED \_\_\_\_\_ IN., \_\_\_\_\_ FT.

SAND \_\_\_\_\_

GAS \_\_\_\_\_

OIL \_\_\_\_\_

TOTAL DEPTH 3592

PRODUCTION

1ST 24 HRS. NAT. \_\_\_\_\_

1ST 24 HRS. AFTER SHOT \_\_\_\_\_

GAS \_\_\_\_\_ CU. FT.

DRY HOLE

ABANDONED

DATE

3/16 1927 \_\_\_\_\_ SCOUT

Location \_\_\_\_\_

Rig up \_\_\_\_\_

Drilling and Remarks:

*TII 3592  
IYA.*

RECORD

Cased \_\_\_\_\_ in., \_\_\_\_\_ ft.

Sand \_\_\_\_\_

Gas \_\_\_\_\_

Oil \_\_\_\_\_

Total Depth \_\_\_\_\_

PRODUCTION

1st 24 hrs. Nat. \_\_\_\_\_

1st 24 hrs. after shot \_\_\_\_\_

Gas \_\_\_\_\_ Cu. Ft.

Dry Hole \_\_\_\_\_

Abandoned \_\_\_\_\_


Date

MAR 16 1927 \_\_\_\_\_ S. J. LEWIS Scout

Map No. K Sec. 26 Twp. 15 R. 2<sup>W</sup>  
 Well No. #1 Shelton Farm

~~Brown & Woodcock~~ Company  
Dancigiretal

\_\_\_\_\_ Ft. from N. Line  
200 Ft. from S. Line  
200 Ft. from E. Line  
 \_\_\_\_\_ Ft. from W. Line

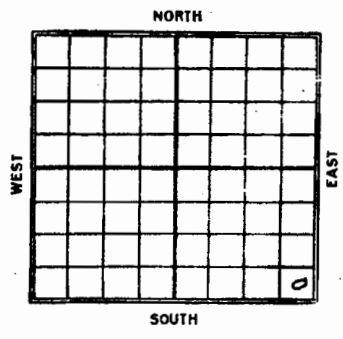

Beneas

Date	REPORT
<u>1924</u>	
<u>11/19</u>	<u>Ry &amp; Fools</u>
<u>11/22</u>	
<u>1925</u>	
<u>1/21</u>	<u>S.D. 1200</u>
<u>1925</u>	
<u>6/2</u>	<u>1480</u>
<u>1926</u>	
<u>6/16</u>	<u>T.D. 1295 - S.L.M. C.O.</u>
<u>6/30</u>	<u>10" @ 1400 - Drlg 1600</u>
<u>7/21</u>	<u>T.D. 1828 U.R.</u>
<u>8/11</u>	<u>T.D. 2266 - at 2440</u>
<u>8/18</u>	<u>" 2268 - U.R. 8"</u>
<u>8/25</u>	<u>Dlg 2470</u>
<u>9/1</u>	<u>" 2730</u>
<u>9/8</u>	<u>" 2770</u>
<u>9/15</u>	<u>T.D. 2835 - U.R. 8"</u>
<u>9/22</u>	
<u>9/29</u>	<u>Drlg 2845 -</u>
<u>10/6</u>	<u>" 2905 -</u>
<u>10/18</u>	<u>U.R. 2905 - T.D.</u>
<u>10/20</u>	<u>no report</u>

10/27 - top chat 2810 shs at  
 2818 - Drlg 2835  
11/3 - J.D. 4320'  
11/10 - Drlg 2865  
11/17 - J.D. 2875 cement  
 8" - S.D. for it to set  
11/24 - J.D. 2875 S.D.  
12/1  
12/8 - Drlg 2985'  
12/15 - " 3100'  
12/31 - same  
12/29 - no report

1927


1/5 - \_\_\_\_\_  
1/12 - T.D. 3288 U.R.  
1/19 - Running 6" @ 3338  
1/26 - Drilling 3387  
2/2 - T.D. 3387 - S.D.  
2/9 - Drilling 3435  
2/16 - Top line 3435  
 Drlg 3455  
2/23 - T.D. 3516 S.L.M. Shut down  
3/2 - no report  
3/9 - Drlg 3590  
3/16 - J.D. 3592 - S & A.

Map No. Kans Sec. 26 Twp. 15 R. 24

Well No. #1 Shelton Farm

~~Brown & Woodcock~~ Company

DONCIGER OIL et al

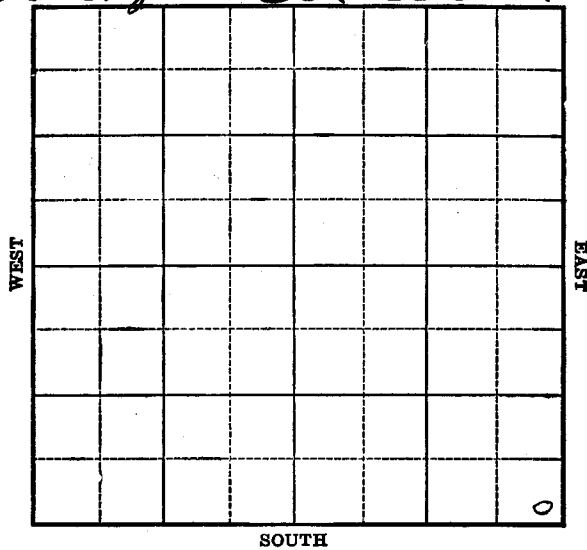

Location \_\_\_\_\_

Drilling Remarks:

\_\_\_\_\_

\_\_\_\_\_

\_\_\_\_\_

\_\_\_\_\_

\_\_\_\_\_

\_\_\_\_\_

\_\_\_\_\_

\_\_\_\_\_

\_\_\_\_\_

\_\_\_\_\_

**RECORD**

Cased \_\_\_\_\_ in. \_\_\_\_\_ ft.

Sand \_\_\_\_\_

Gas \_\_\_\_\_

Oil \_\_\_\_\_

Total Depth \_\_\_\_\_

Rig Up \_\_\_\_\_

Drilling Remarks:

\_\_\_\_\_

\_\_\_\_\_

\_\_\_\_\_

\_\_\_\_\_

\_\_\_\_\_

\_\_\_\_\_

\_\_\_\_\_

\_\_\_\_\_

\_\_\_\_\_

\_\_\_\_\_

**PRODUCTION**

1st 24 hrs. Nat. \_\_\_\_\_

1st 24 hrs. after shot \_\_\_\_\_

Gas \_\_\_\_\_ cu. ft.

Dry Hole \_\_\_\_\_

Abandoned \_\_\_\_\_