

Ellis

KANSAS
20W

Sec. 3 Twp. 15 R. 20W

#1 Phillips

Well No. Farm

Barnett Drlg.

Company

Barnett

Wildcat

Contractor

Ft. from N. Line

330


Ft. from S. Line

Ft. from E. Line

330

Ft. from W. Line

SW SW SW

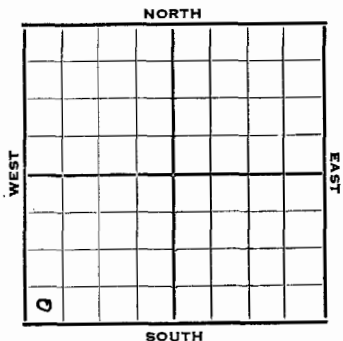


KANSAS

Section 3 Township 15 Range 20W

Well No. #1 Phillips

Company Barnett Drlg.

NORTH

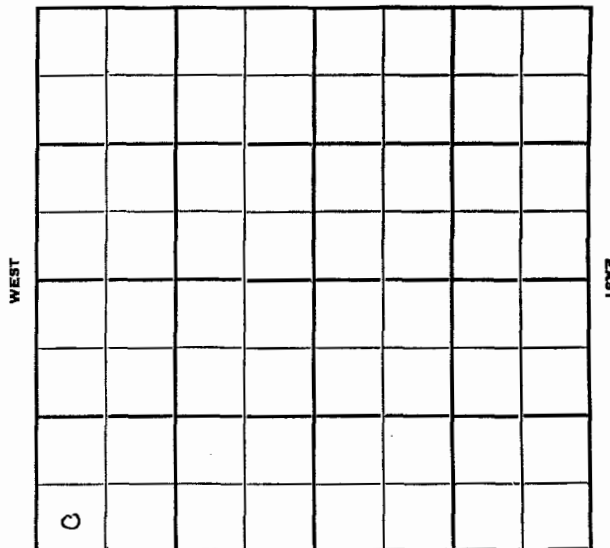

SOUTH

1952 Elev. 2032' REPORT

6/18 Spud 6-5-52
13" @ 175'
Anhy 1275'
Drlg. 3320'

6/25 Spud 6-5-52
D&A TD 3765' 13" @ 175'
Anhy 1275 Top. 3100
Heeb. 3321 Lans. 3364
KC 3603 Cong. 3726
Arb. 3744
TD 3765 D&A

ABANDONED