

Map No. KANSAS Sec. 4 Twp. 15 R. 20 WWell No. 1 GatewoodRush Oil Company

Contractor

SECTION PLAT

330 Ft. from N. Line

Ft. from S. Line

Ft. from E. Line

330 Ft. from W. Line

FIRST REPORTS

Location

Rig up

Drilling and Remarks:

Rig

RECORD

Cased _____ in., _____ ft.

Sand _____

Gas _____

Oil _____

Total Depth _____

PRODUCTION

1st 24 hrs. Nat. _____

1st 24 hrs. after shot _____

Gas _____ Cu. Ft.

Dry Hole _____

Abandoned _____

Date

JUN 6 1928

S. J. LEWIS

Scout

Map No. KANSAS Sec. 4 Twp. 15 R. 20 WWell No. 1 GatewoodJoe Sweeney & Co. Company

Contractor

SECTION PLAT

330 Ft. from N. Line

Ft. from S. Line

Ft. from E. Line

330 Ft. from W. LineCorrection

Location

Rig up

Drilling and Remarks:

Joe Sweeney
Edel have taken
this over from
the Rush Oil

RECORD

Cased _____ in., _____ ft.

Sand _____

Gas _____

Oil _____

Total Depth _____

PRODUCTION

1st 24 hrs. Nat. _____

1st 24 hrs. after shot _____

Gas _____ Cu. Ft.

Dry Hole _____

Abandoned _____

Date

JUN 8 1928

S. J. LEWIS

Scout

Map No. 75 KANSAS Sec. 4 Twp. 15 R. 20 WWell No. 1 Gatewood

Joe Lisenby et al Company

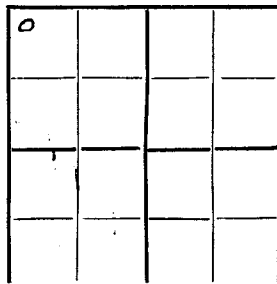
Contractor

SECTION PLAT

330 Ft. from N. Line

Ft. from S. Line

Ft. from E. Line

330 Ft. from W. Line

ABANDONED

Location

Rig up

Drilling and Remarks:

RECORD

Cased in., ft.Sand Gas Oil Total Depth 3880

PRODUCTION

1st 24 hrs. Nat. 1st 24 hrs. after shot Gas Cu. Ft.Dry Hole Abandoned

Date

OCT 8 1930

S. J. LEWIS Scout

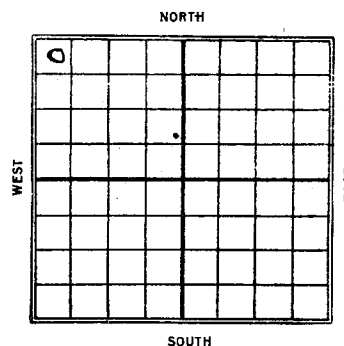
Map No. 75 KANSAS Sec. 4 Twp. 15 R. 20 WWell No. 1 Gatewood Farm~~Rush Oil~~ Company

Joe Lisenby

330 Ft. from N. Line

Ft. from S. Line

Ft. from E. Line

330 Ft. from W. Line

1928

Date

REPORT

6/6	Rig
6/13	
6/20	Rigging up-
6/27	Rigged up-
7/3	Spud 40'
7/11	
7/18	Drlg 480-
7/25	T.D. 480-S.D.
8/1	
8/7	
8/15	
8/22	run 15" @ 485'
9/5	drlg 614'
9/12	show oil @ 840'
	drlg. 900'
9/19	T.D. - 1100' up rig.
9/26	S.D. - 1100' - T.D.
10/3	
10/10	
10/17	
10/24	
10/31	

N17- S.D. 1100' - T.D.

11/14

11/21

11/28

12/5

12/12

12/19

12/26

1929

1/2

1/9

1/16

1/23

1/30

2/6

2/13

2/20

2/27

3/6

3/13

3/20

3/27- Only 1200'

4/3- S.D. 1200' T.D.

4/10- Only 1345'

4/17- T.D. 1375' - S.D.

4/24- Only 1600'

5/1

5/8- Cen. off water 1600'

5/14

5/22- Only 2130'

5/29- fsg tools 2395'

6/5- S.D. 2495'

6/12

6/19- Only 2525'

6/26- fsg tools 2555'

7/2

7/10

7/17

7/24

7/24- S.D. 2555'

7/31

FORM NO. 5M-12-28-PETROL

Map No. Kans. Sec.

Well No.

Company

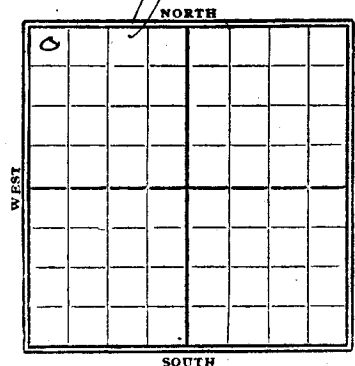
330 Ft. from N. Line

Ft. from S. Line

Ft. from E. Line

330 Ft. from W. Line

1929



Date

REPORT

8/7 fsg tools 2555' T.D.

5/10 there

8/14 fsg tools 2555'

8/21

8/28

9/4

9/11

9/18

9/25

10/2

10/9

10/16

10/23

10/30

11/6

11/13

11/20 S.D. 2555'

11/27

12/4

12/11

12/18

12/23

12/30

1/29

1930

2/5 Only

1/8

1/15

1/22

2680

(over)

7/9 —

[illegible]

0

J

WEST

EAST

SOUTH

Drilling Remarks

PRODUCTION

1st 24 hrs. Nat.

1st 24 hrs. after shot

Gas..... cu. ft.

Dry Hole

Abandoned