

WILDCAT

FORM 513 SUNRAY

County Ellis Elev. _____
 Sec. 6 Twp. 15 Rge. 20W
 Company Bankoff Oil
 Farm Name Bollig No. 1

TOPS	DEPTH	LOG	DATUM	Loc. in Sec.
Anh.				C W ¹ NW NW
Tr.				
H.				
Tr.				
Dg.				
BL.				
L.				
K.C.				Geol. _____
B.K.C.				Cont. _____
Cc.				Kan-Tex
C.				
M.				Part _____
M.				Wildcat
K.				
Mz.				
Me.				
V.				
S.				
S.				
A.				
R.				
PE.				
G.				
TD				


Date Comm. 1-27-57 Shell - DHM
 drlg. 1125

14

Ellis

KANSAS

SECTION 6 TOWNSHIP 15 RANGE 20W
 WELL NO. #1 Bollig
 COMPANY Bankoff Oil

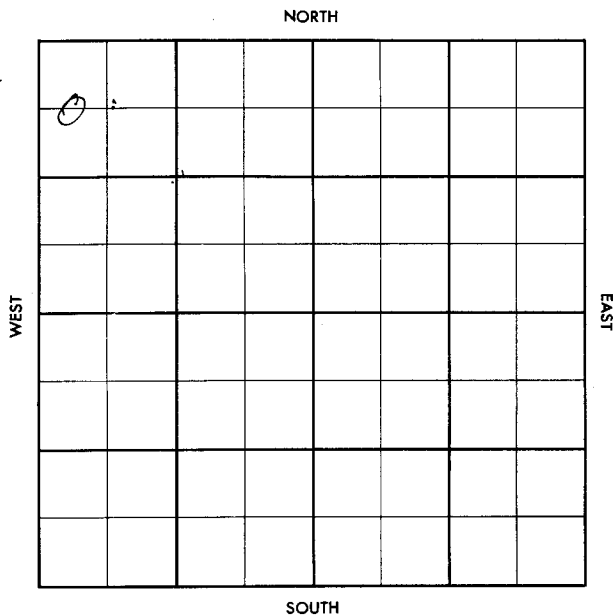

County	Ellis	Elev.	2023
Sec.	6	Twp.	15
Range	20W	Comp.	Bankoff Oil
Farm Name	Bollig	No.	1

TOPS	DEPTH	LOG	DATUM	Loc. in Sec.
Anb.	1333			C NW NW
TP.				
H.	3352			
Th.	3372			
Dp.				
Bl.				
L.	3393	3394		
K.C.	3207	3660		Geol.
B.K.C.				Contr.
Ca.	3769	3766		Kan-Tex
C.				
M.				
M.				
K.				
Sh.				Wildcat
Ma.				
V.				
S.				
S.	3818	3817		
R.				
Pe.				
G.				
TA	3868			ABANDONED

Date Comm. 1-17-57

Shell - DHM

drlg. 1125

JAN 28 57

878 1341/600

10 3225

JAN 30 57

DST 3763-3800

30" cas 25' Md BHT 51d/30

DEA