


Map No. **KANSAS** Sec. 13 Twp. 15 R. 20-W

Well No. 1-Penny Wann Farm  
Bradley Oil et al Company

10/7/36-Basil sand 3653'.  
T.D. 3658'.  
Potential 420 bbls in 22½ hrs.

**COMPLETED**

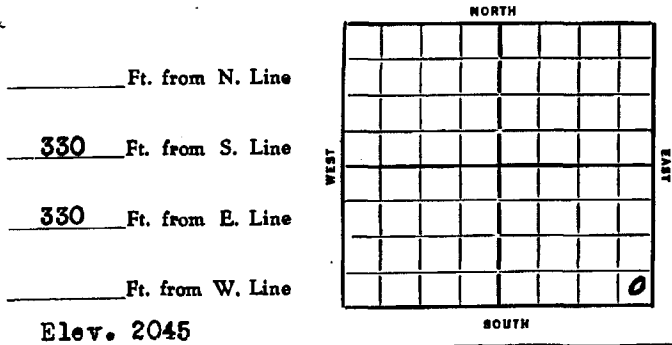

Date	REPORT
<del>1936</del>	
4/22	Location
4/30	--5/7--5/14--
5/21	20" @ 19'. T.D. 48'. WOC.A
5/28	Drlg. 600'.
6/4	Anhydrate 1277'. 1295'. Reaming.
6/11	12" @ 1277'. Drlg. 2645'.
6/18	Drlg. 2875'.
6/25	K.C. 3337'. Drlg. 3340'.
7/2	8" @ 3341'. Waiting on cement.
7/9	--7/16--
7/23	Drlg. 3403'.
7/30	3425' fishing.
8/6	--8/13--
8/2-	Drlg. 3425'.
8/27	Shut down/
9/3	3425' shut down.
9/10	Base Kansas City 3585'. Drlg. 3615'
9/18	5" @ 3631'. Drlg. 3633'.
9/24	Basil sand 3653' oil 3655-57'. 1150' of oil in 3 hours. 28 gravit;
10/1	TD 3658'. 3100' oil in hole.
<b>OVER</b>	

Map No. 75 Sec. 13 Twp. 15 R. 20W

Well No. 1 Penny Hann

Bradley Oil & Gas Company

Contractor

SECTION PLAT


..... Ft. from N. Line  
330 Ft. from S. Line  
330 Ft. from E. Line  
..... Ft. from W. Line

FIRST REPORT

Location ✓

Rig up .....

Drilling and Remarks:

RECORD

Cased ..... in., ..... ft.  
Sand .....

PRODUCTION

1st 24 hrs. Nat. ....  
1st 24 hrs. after shot .....

Date

APR 22 1936 192 S. J. LEWIS Scout

Map No. 75 Sec. 13 Twp. 15 R. 20W

Well No. 1 Penny Hann

Bradley Oil & Gas Company

Contractor

SECTION PLAT


..... Ft. from N. Line  
330 Ft. from S. Line  
330 Ft. from E. Line  
..... Ft. from W. Line

Location .....

Rig up .....

Drilling and Remarks:

Basin 3653

P 8420-22 1/2 hrs

RECORD

Cased ..... in., ..... ft.  
Sand .....

PRODUCTION

1st 24 hrs. Nat. ....  
1st 24 hrs. after shot .....

Date

OCT 7 1936 19 S. J. LEWIS Scout

Form 51-5M-4-86-Palace

Section 13 Township 15 Range 20-W

Well Number 1-Penny Wann

Company Bradley Oil et al

