

KANSAS
Map No. 75 Sec. 14 Twp. 15 R. 20WWell No. 1 Penny-Wann

Falcon-Seaboard

Company

FIRST REPORT

Contractor

C NL NW NW

SECTION PLAT

330 Ft. from N. Line

Ft. from S. Line

Ft. from E. Line

660 Ft. from W. Line

WILDCAT

Location XXX

RECORD

Cased _____ in., _____ ft.

Sand _____

Gas _____

Oil _____

Total Depth _____

PRODUCTION

1st 24 hrs. Nat. _____

1st 24 hrs. after shot _____

Gas _____ Cu. Ft.

Dry Hole _____

Abandoned _____

Date

JAN 6 1943 19 S. J. LEWIS Scout

KANSAS
Map No. 75 Sec. 14 Twp. 15 R. 20WWell No. 1 Penny-Wann

Falcon-Seaboard

Company

ABANDONED

Contractor

C NL NW NW

SECTION PLAT

330 Ft. from N. Line

Ft. from S. Line

Ft. from E. Line

660 Ft. from W. Line

WILDCAT

Location _____

RECORD

Cased _____ in., _____ ft.

Sand _____

Gas _____

Oil _____

Total Depth 386'

PRODUCTION

1st 24 hrs. Nat. _____

1st 24 hrs. after shot _____

Gas _____ Cu. Ft.

Dry Hole _____

Abandoned _____

Date

FEB 17 1943 19 S. J. LEWIS Scout

KANSAS

Ellis

Sec. 14 Twp. 15 R. 20-W

Well No. #1 Penny-Wann Farm
Falcon-Seaboard Company

Wildcat


330 Ft. from N. Line

_____ Ft. from S. Line

_____ Ft. from E. Line

660 Ft. from W. Line

Elev. 2067

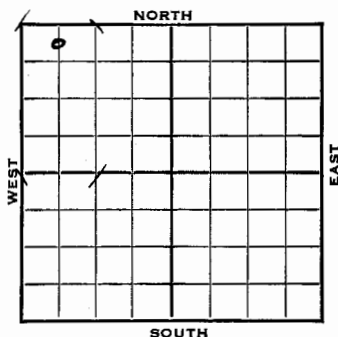

1943 REPORT

1/6 Location
1/13 Rotary
1/20 Surface hole.
1/27 Drlg. 1900'
2/3 16" casing set 104'
Anhy 1325'
Drlg. 2200'
2/10 Lans 3380
Stains 3417-20
Drlg. 3430'
2/17 BKC 3633
Cherty Cong. 3728 Granite 3859
T.D. 3861'
No Arb.

ABANDONED

KANSAS

FORM 51 5M 10-41 PETROL

Ellis

Section 14 Township 15 Range 20-W

Well No. #1 Penny-Wann

Company Falcon-Seaboard

