

Pool Name Penny WannMap No. 75 Sec. 14 Twp. 15 R. 20WWell No. 1 C. M. Wann "B"Stanolind

Company

FIRST REPORT

Contractor

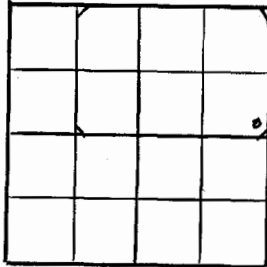
SE NE

SECTION PLAT

Ft. from N. Line

330 Ft. from S. Line330 Ft. from E. Line

Ft. from W. Line

Ellis

Location

Rig up

Drilling and Remarks:

R U R

RECORD

Cased in, ft.

Sand

Gas

Oil

Total Depth

PRODUCTION

1st 24 hrs. Nat.

1st 24 hrs. after shot

Gas Cu. Ft.

Dry Hole

Abandoned

Date

NOV 8 1944 19S. J. LEWIS ScoutPool Name Penny WannMap No. 75 Sec. 14 Twp. 15 R. 20WWell No. 1 C. M. Wann "B"Stanolind

Company

ABANDONED

Contractor

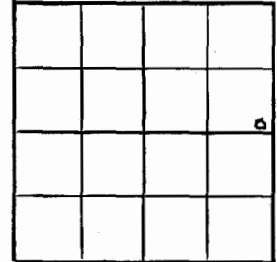
SE NE

SECTION PLAT

Ft. from N. Line

330 Ft. from S. Line330 Ft. from E. Line

Ft. from W. Line

Ellis

Location

Rig up

Drilling and Remarks:

Reagan 3655
SW.

RECORD

Cased in, ft.

Sand

Gas

Oil

Total Depth 3655

PRODUCTION

1st 24 hrs. Nat.

1st 24 hrs. after shot

Gas Cu. Ft.

Dry Hole

Abandoned

Date

DEC 6 1944 19S. J. LEWIS Scout

KANSAS

Ellis County

Sec. 14 Twp. 15 R. 20W

Well No. #1 C. M. Wann "B" Farm

Stanolind Company

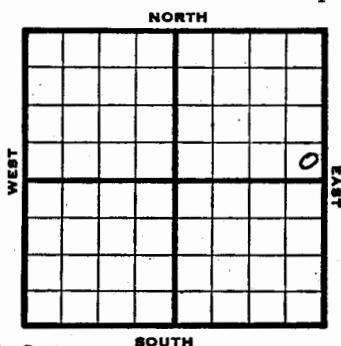
Penny Wann

Ft. from N. Line

330 Ft. from S. Line

330 Ft. from E. Line

Ft. from W. Line



SE NE Elev. 2020

1944 REPORT

11/8 RUR

11/16 13" @ 103'
Drlg. 1115'

11/24 anhy 1255 8" @ 1259 Drlg. 2220

11/29 Lans 3325 Drlg. 3375

12/6 Reagan 3655'
TD 3658'
SW

ABANDONED

KANSAS

Ellis County

Section 14 Township 15 Range 20W

Well No. #1 C. M. Wann "B"

Company Stanolind

