

Kansas

Map No. _____ Sec. 24 Twp. 15 R. 2 OWWell No. 1 Werth

Lindas Oil _____ Company

FIRST REPORT _____ Contractor

C N I NE NE


SECTION PLAT

330 Ft. from N. Line

_____ Ft. from S. Line

660 Ft. from E. Line

_____ Ft. from W. Line

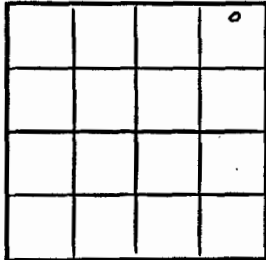

Ellis County

Location _____

Rig up _____

Drilling and Remarks:

R U R

RECORD

Cased _____ in., _____ ft.

Sand _____

Gas _____

Oil _____

Total Depth _____

PRODUCTION

1st 24 hrs. Nat. _____

1st 24 hrs. after shot _____

Gas _____ Cu. Ft.

Dry Hole _____

Abandoned _____

Date

OCT 15 1947 19 S. J. LEWIS Scout

Kansas

Map No. 75 Sec. 24 Twp. 15 R. 2 OWWell No. 1 Werth

Lindas Oil _____ Company

ABANDONED _____ Contractor

C N L NE NE


SECTION PLAT

330 Ft. from N. Line

_____ Ft. from S. Line

660 Ft. from E. Line

_____ Ft. from W. Line

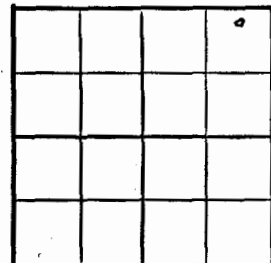

Ellis County

Location _____

Rig up _____

Drilling and Remarks:

Liam 3342BTC 3557Reagan 3662

RECORD

Cased _____ in., _____ ft.

Sand _____

Gas _____

Oil _____

Total Depth 3667

PRODUCTION

1st 24 hrs. Nat. _____

1st 24 hrs. after shot _____

Gas _____ Cu. Ft.

Dry Hole _____

Abandoned _____

Date

NOV 5 1947 19 S. J. LEWIS Scout

KANSAS

Ellis



Sec. 24 Twp. 15 R. 20W

Well No. #1 Werth Farm

Lindas Oil Company

Penny Wahn


330 Ft. from N. Line

Ft. from S. Line

660 Ft. from E. Line

Ft. from W. Line

C N L N E N E

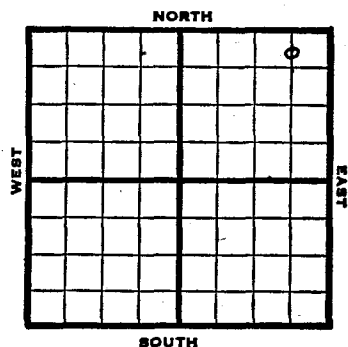

KANSAS


Ellis

Section 24 Township 15 Range 2 OW

Well No. 1 Werth

Company Lindas Oil

Penny Wahn

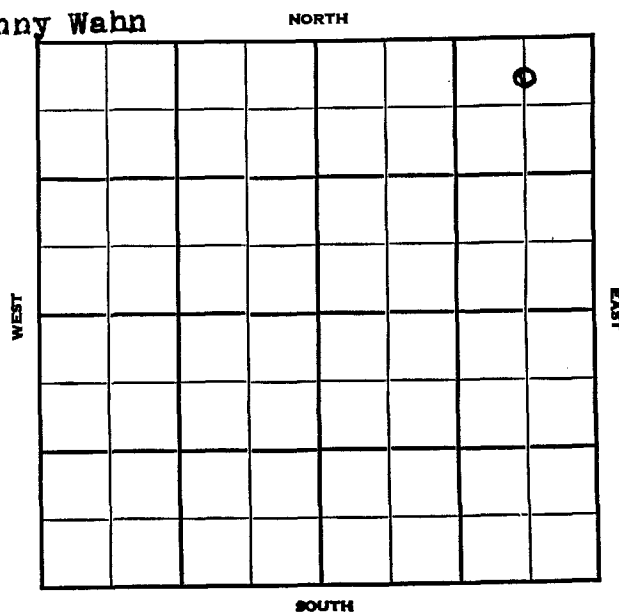

1947

Elev. 2044' REPORT

10/15 RUR

10/22 8" @ 1280'
Drlg. 1380'

11/5 Lansing 3342'
BKC 3588'
Reagan 3662'
Total Depth 3667'

ABANDONED