

Sec. 28 Twp. 15 R. 20 W

Well No. # 1 Mutual Farm

Buffalo Oil & Rine Drlg. Company

Contractor

Wildcat


Ft. from N. Line

330 Ft. from S. Line

Ft. from E. Line

330 Ft. from W. Line

SW SW NW

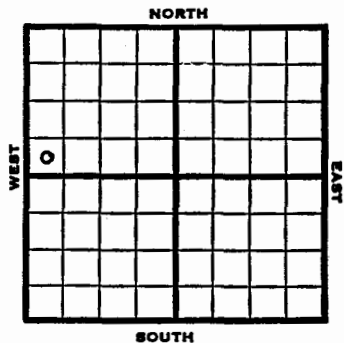


Section 28 Township 15 Range 20 W

Well No. # 1 Mutual

Company Buffalo Oil & Rine Drlg.

NORTH

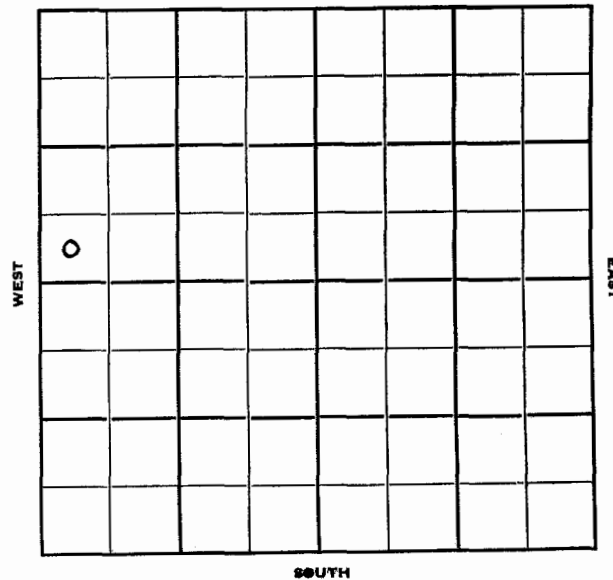

SOUTH

10-17

1951 Elev. 2189' REPORT

3/28 Location

4/18 Spud 3-27-51 D & A TD 4055'
 12 1/4" @ 194, Anhy 1440-80', Lans 3521'
 DST 3587-3606 open 1 hr. rec 60' SW
 DST 3841-60 open 20 min. rec 10' mud
 Marmaton 3856'
 DST 3975-4010 open 1/2 hr. rec 990' SW
 Cong. 3901', Regan 3917', Gr. wash
 3988', Granite 4010'
 TD 4055' D & A

ABANDONED