

Ellis - Co

Map No. **KARONG** Sec. **33** Twp. **15** R. **20W**

Well No. **1 Murphy**
Asenthal et al Company

Contractor

FIRST REPORT

SECTION PLAT

300 Ft. from N. Line
Ft. from S. Line
Ft. from E. Line
300 Ft. from W. Line

		o	

Location
Rig up
Drilling and Remarks:

RECORD
Cased _____ in., _____ ft.
Sand _____
Gas _____
Oil _____
Total Depth _____

PRODUCTION
1st 24 hrs. Nat. _____
1st 24 hrs. after shot _____
Gas _____ Cu. Ft.
Dry Hole _____
Abandoned _____

Date **NOV 23 1924**
M. A. BENEAR
192 Scout

MAP NO. SEC. **33** TWP. **15S** R. **20W**

WELL NO. **1 Murphy**
C. B. Salter COMPANY

CONTRACTOR

no wall
_____ FT. FROM N. LINE
_____ FT. FROM S. LINE
_____ FT. FROM E. LINE
_____ FT. FROM W. LINE

SECTION PLAT

		o	

LOCATION
RIG UP
DRILLING AND REMARKS:

RECORD
CASED _____ IN., _____ FT.
SAND _____
GAS _____
OIL _____
TOTAL DEPTH **300**


PRODUCTION
1ST 24 HRS. NAT. _____
1ST 24 HRS. AFTER SHOT _____
GAS _____ Cu. Ft.
DRY HOLE _____
ABANDONED _____

DATE **1/21** 192 **6** Scout

Map No. KANSAS Sec. 33 Twp. 15 R. 20

Well No. 1 Murphy
Rosenthal et al. Company
Contractor

SECTION PLAT

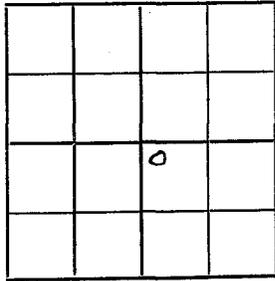

300 Ft. from N. Line
Ft. from S. Line
Ft. from E. Line
300 Ft. from W. Line

ABANDONED

Location _____ Rig up _____ Drilling and Remarks: <u>T 3610</u> <u>W & A.</u>	RECORD	
	Cased _____ in., _____ ft.	
	Sand _____	
	Gas _____	
	Oil _____	
Total Depth _____		
PRODUCTION		
1st 24 hrs. Nat. _____		
1st 24 hrs. after shot _____		
Gas _____ Cu. Ft.		
Dry Hole _____		
Abandoned _____		


Date FEB 8 1926
S. J. LEWIS Scout

Ellis - C

Map No. Kans Sec. 33 Twp. 15 R. 20

Well No. 1 Murphy Farm
Rosenthal et al Company

NORTH

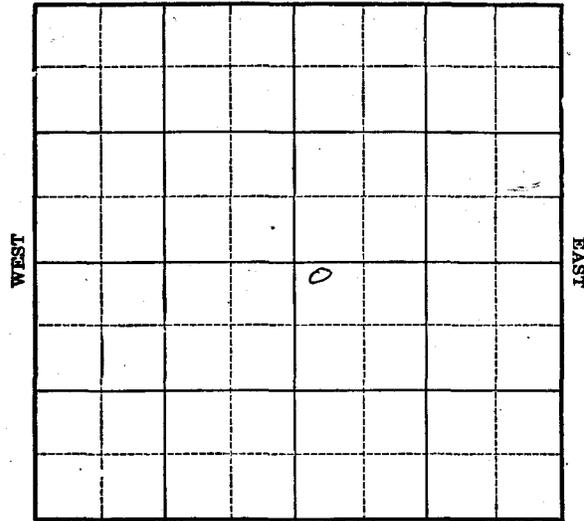

SOUTH

Location _____
Drilling Remarks _____

Rig Up _____
Drilling Remarks _____

RECORD

Cased _____ in. _____ ft.
Sand _____
Gas _____
Oil _____
Total Depth _____

PRODUCTION

1st 24 hrs. Nat. _____
1st. 24 hrs. after shot _____
Gas _____ cu. ft.
Dry Hole _____
Abandoned _____