
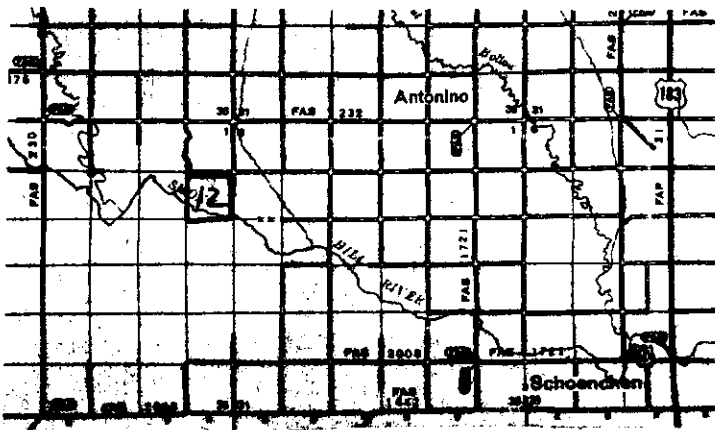


12-15-80W

RUPE OIL
#1 STEVENS
SE SW SW
990' FWL 330' FSL
SECTION 12, T15S, R20W
ELLIS COUNTY, KANSAS

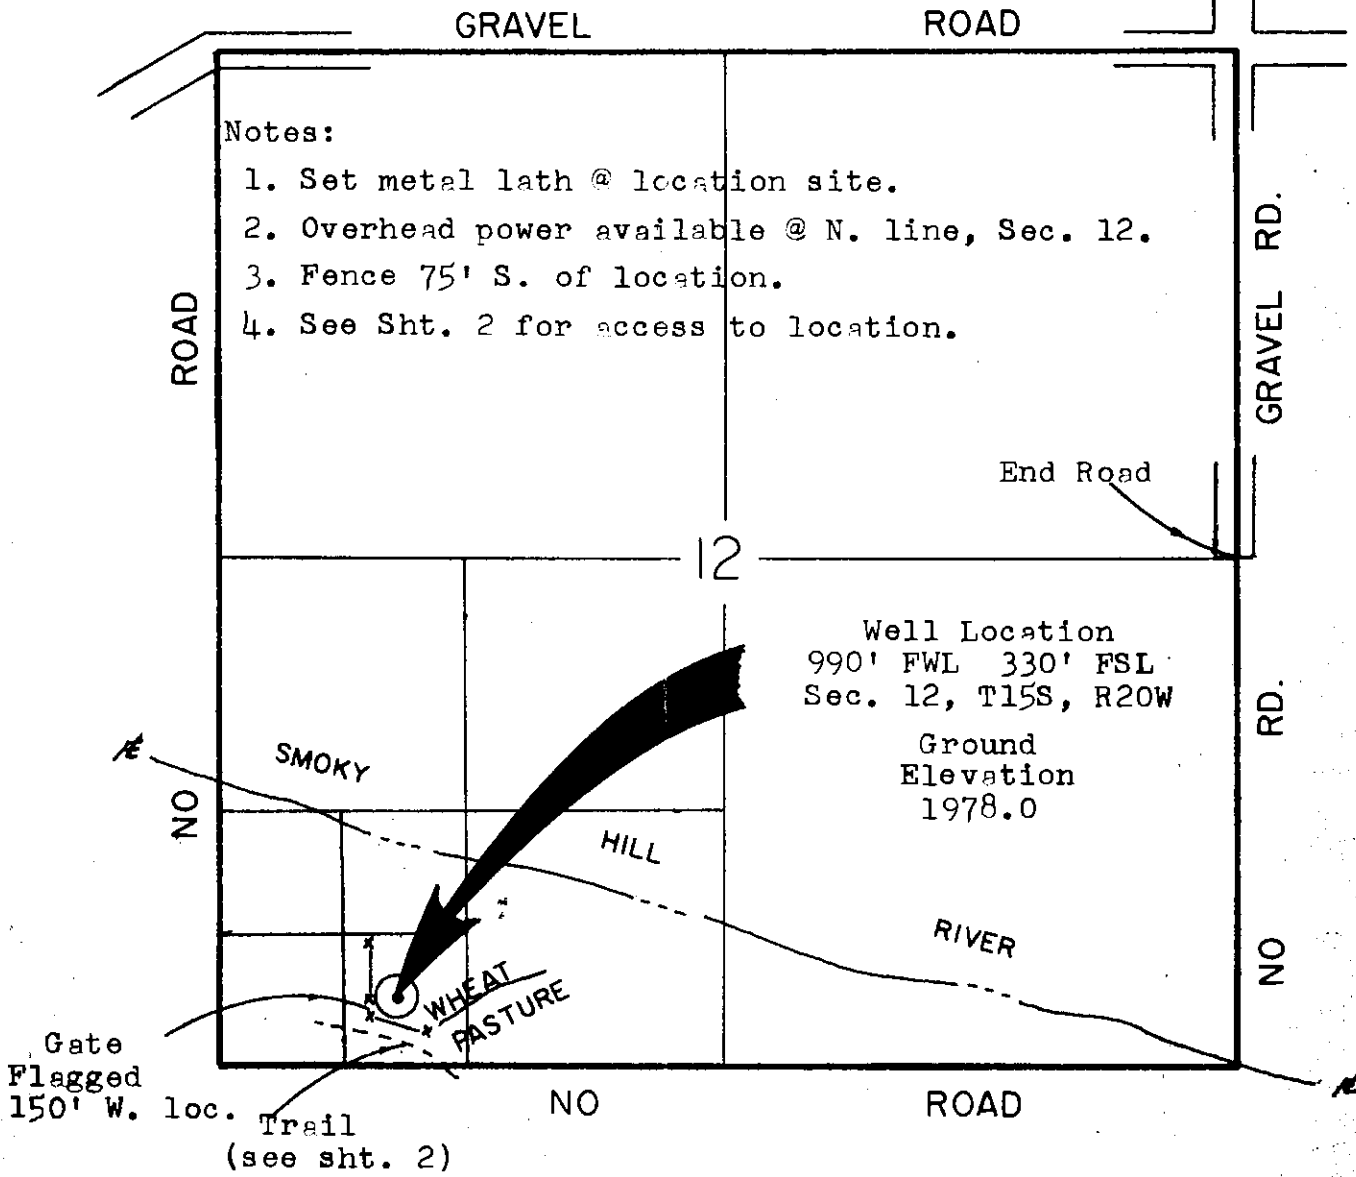

Randy E. Anderson
Randy E. Anderson, R.L.S. 802

Date December 30, 1982

