

Kansas

County Trego State Kansas

Sec. 1 (Blk. Twp.) 15 (Sur. Rge.) 21W Map No. _____

Operator Deep Rock

Well No. 1 Farm Moore

Elev. _____ Location SE SE NW

330 Ft. From S Line NW

330 Ft. From E Line Quarter

1st. Report JUL 20 1953

Completion _____

Remarks Rine Drlg. - Contr.

Spudding Date _____

Drlg. Data Wildcat

H I M

Map No. _____ Sec. 1 Twp. 15 R. 21W

Well No. 1 Moore

Deep Rock Company

CORRECTION Contractor

C S L SE NW

SECTION PLAT

_____ Ft. from N. Line

360 Ft. from S. Line

840 Ft. from E. Line

_____ Ft. from W. Line

Trego County

Location _____

Rig up _____

Drilling and Remarks:

Reported

SE SE NW

RECORD

Cased _____ in., _____ ft.

Sand _____

Gas _____

Oil _____

Total Depth _____

PRODUCTION

1st 24 hrs. Nat. _____

1st 24 hrs. after shot _____

Gas _____ Cu. Ft.

Dry Hole _____

Abandoned _____

Date

AUG 5 1953 19

J. G. McGEHEE Scout

J. G. McGEHEE

KANSAS ✓

Trego

Sec. 1 Twp. 15 R. 21WWell No. #1 Moore Farm

Deep Rock

Company

Rine Drlg.

Contractor

Wildcat

Ft. from N. Line

Ft. from S. Line


Ft. from E. Line

Ft. from W. Line

~~SE SE NW~~

CSN SE NW

NORTH

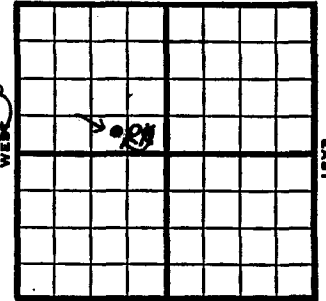

SOUTH

1953

Elev. 2062'

REPORT

7/29 MIM

8/12 Spud 7-30-53

D & A TD 3902 13" @ 350 Anhy 1375

Heeb 3370 Tor. 3392 Lans 3411

B KC 3658 Marm. 3742 Arb. 3858

TD 3902 D & A

ABANDONED

J. G. McGEHEE

County Trego State KansasSec. 1 (Blk. 15) (Sur. 21W) Map No.Operator Deep RockWell No. 1 Farm MooreElev. 2062 Location C S L SE NW

360 Ft. From S Line NW

840 Ft. From E Line Quarter

1st. Report

Completion AUG 12 1953Remarks WildcatRine Drlg. - Contr.Spudding Date 7-30-53Drlg. Data D & A TD 3902

13" @ 350 Anhy 1375 Heeb. 3370

Tor. 3392 Lans. 3411 B KC 3658

Marm. 3742 Arb. 3858 TD 3902

D & A

FORM 51

Trego

KANSAS

Section 1 Township 15 Range 21W

Well No. #1 Moore

Company Deep Rock

