

Trego KANSAS

Sec. 4 Twp. 15 R. 21 W

Well No. # 1 Nicholson Farm

M. B. Armer Company

Mid-American Contractor


Wildcat

Ft. from N. Line

330 Ft. from S. Line

Ft. from E. Line

330 Ft. from W. Line

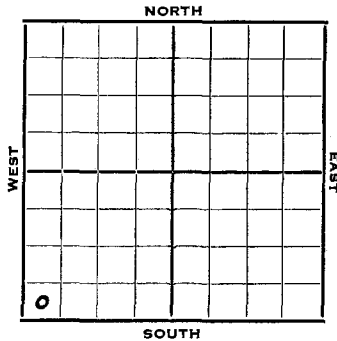


Trego KANSAS

Section 4 Township 15 Range 21 W

Well No. # 1 Nicholson

Company M. B. Armer

NORTH

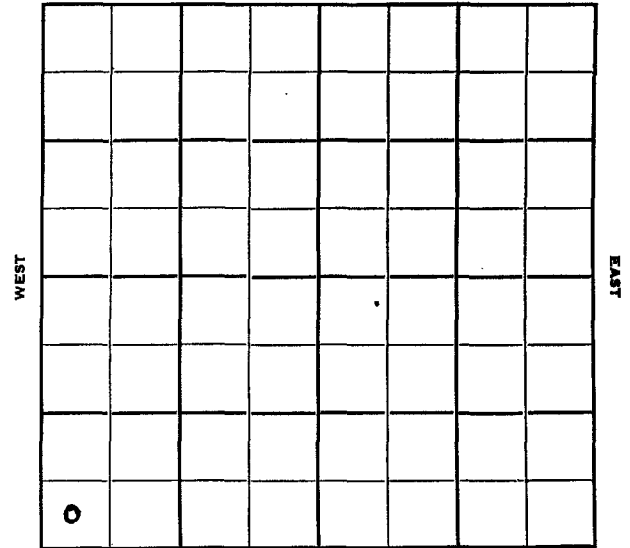

SOUTH

SW SW SW

Phillips - DHM

~~Lario DHM \$3,000.~~

1952 Elev. 2161' REPORT

2/27 MI

3/5 8" @ 200' WOC

3/11 Drlg. 2555'

3/19 Anhy 1190 Heeb. 3528

Tar 3548 Lans. 3569

Drlg. 3590'

4/2 Spud 3-1-52

D&A TD 4187'

8" @ 200

Anhy 1190 Heeb. 3528

Tor. 3548 Lans. 3568

Cong. 4010

DST 4003-21 open 1 hr. rec. 30' mud

Howard 3084 Top. 3126

B KC 3826 Marm. 3842

Cherokee 3969 Miss. 4082

Arb. 4137

TD 4187'

D&A

ABANDONED