Trego


SEC.	TWP.	R.
20	15 S	21 W

WELL NO. # 2 C. Kutina FARM

COMPANY Atlantic & SDX (DEVELOPMENT-OBOCO)

CONTRACTOR Peel Bros.

Kutina Field

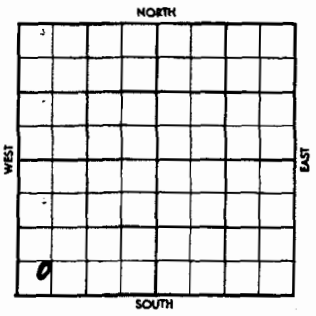

_____FT. FROM N. LINE

_____FT. FROM S. LINE

_____FT. FROM E. LINE

_____FT. FROM W. LINE

150' SW of C SW SW

ELEVATION 4350' Cherokee Test REPORT-

1957	
5/1	Location (FR Tkt)
5/3	MIRT (DR#87-1957)
5/6	RURT
5/7	Spudded 5-4-57 Drlg. 1325'
5/8	Drlg. 2571'
5/9	Drlg. 2665'
5/10	TD 2665' NR
5/13	Drlg. 3385'
5/14	Drlg. 3891'
5/15	Drlg. 3990'
5/16	Drlg. 4108'
5/17	TD 4186'. Prep to DST
5/20	Coring @ 4236'
5/21	TD 4236' Ran EL. WOO
5/22	TD 4312' Rng. csg.
5/23	TD 4312' WOC. 5" csg.
5/24	TD 4312'. NR
5/27	TD 4312' WOR
5/28	TD 4312'. Prep to drill plug.
5/29	TD 4312'. Testing perfs 4161-4165' & 4172-4174'

OVER

FORM 504-S SUNRAY

1957	
5/31	TD 4312'. Prep to frac perfs 4161-65'
6/3	TD 4312'. Flowing load oil "
6/4	TD 4312' " "
6/5	" " "
6/6	TD 4312'. " "
6/7	" " "
6/10	TD 4312'. N.R. Perfs 4161-65'
6/11	TD 4312' " "
6/12	TD 4312'. " "
6/13	" " "
6/14	" " "
6/17	TD 4312'. NR. "
6/18	" " "
6/19	" " "
6/20	" " "
6/21	" " "
6/24	TD 4312'. Pumping load oil. Perfs 4161-4165'
6/25	" " "
6/26	" " "
6/27	" " "
6/28	TD 4312' Pumped 50 BO 24 hrs. Perfs 4161-4165' Cherokee Zone Complete (DR#126)

FORM 518 SUNRAY

County Trego Elev. GST 2315 DF

Sec. 20 Twp. 15 Rge. 21W

Atlantic & Sunray Mid-Continent

Lse. Kutina No. 2

TOPS	DEPTH	LOG	DATUM
Anh.			
Tp.			
H.	3691	3695	
Tr.	3713	3715	
Dg.			
Bl.			
L.	3732	3736	
K.C.			
Bkc. Ft sct	4076		
Ce.	4132	4142	
← Kutina Zn		4248	
M.	4256	4266	
M.			
K.			
Mr.			
Mo.			
V.			
S.			
S.			
A			
R.			
Pe.			
G.			
TD	4312		

Loc. in Sec. 150' SW of C SW SW

Cont. Peel Bros.

Pool KUTINA

COMPLETED

Date Comm. Location spd 5-4-57 8 5/8 254/250 Ø 257 MAY 15 57 Ø 4005 MAY 22 57 Ft sct 4076 Ce 4132 DST 4130-86 op 1 hr. rec 158' SO & GCM + 60' HOCM NW IBHP 1365 FBHP 1215 crg @ 4236-61 DST 4237-61 op 1 hr rec 1830' SW FP 457-897 BHP 1145/30" Miss 4256 DST 4266-4312 op 1 hr rec 20' Md

Sec. 20 T. 15 R. 21W

FORM 518-1 SUNRAY

FP 68- BHP 978/30" (To run csg & tst zn. 4161-65 this zn showed 14% poro. MAY 29 '57 5½ @ JUN 5 '57 4312 CO 4223 8/4172-74 tst 550 mcfpd 16/4161-65 FU 100' oil 1 hr 900' oil 15 hrs no/w & 2153 Ba in 5 hr. Frac 5X1 Sfd. JUN 12 '57 P. Ld. JUN 19 '57 P. 50 BO 24 hrs no/w JUN 26 '57 XHP. 53 Bopd no/w grav 42°

20-15-21W C SW SW

FORM 513 SUNRAY

County Trego Elev.

Sec. 20 Twp. 15 Rge. 21W

Company Atlantic & Sunray Mid-Continent

Farm Name C. Kutina No. 2

TOPS	DEPTH	LOG	DATUM
Anh.			
Tp.			
H.			
Tr.			
Dg.			
Bl.			
L.			
K.C.			
B.K.C.			
Ce.			
C.			
M.			
M.			
K.			
Mz.			
Mc.			
V.			
S.			
S.			
A			
R.			
P€.			
G.			
TD			

Loc. in Sec. 150' SW of C SW SW

Geol.

Contr.

Pool Peel Prod.

Pool Kutina

FIRST REPORT

MAY 1 '57

0

Date Comm.

Location


Co. Lse. No. Sec. T. R.

Trego KANSAS

SECTION 20 TOWNSHIP 15 RANGE 21W

WELL NO. #2 C. Kutina

COMPANY Atlantic & Sunray Mid-Continent

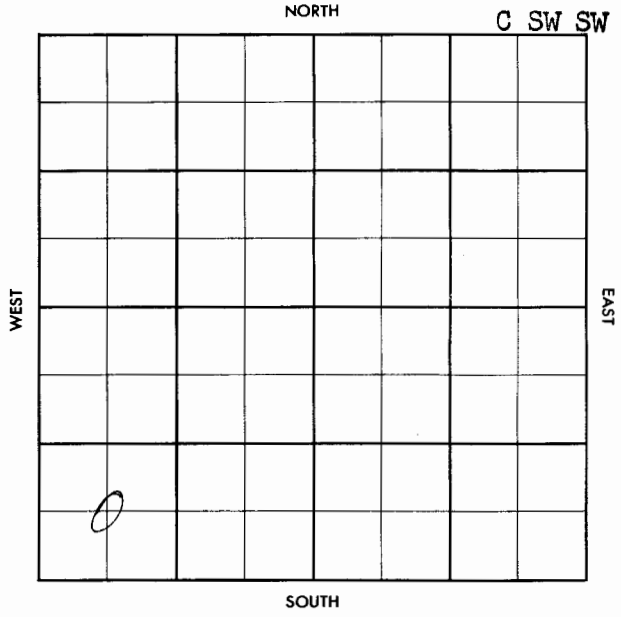

FORM 504-3 SUNRAY