



Trego KANSAS

SEC.	TWP.	R.
11	15	22W

1954  
6/9


(Information continued)  
500 A S/1 BOPH CO to 4305  
S/1 BOPH D & A

WELL NO. 1 Coulson FARM

COMPANY BradenDrlg. & NACC

CONTRACTOR BradenDrlg. Wildcat

\_\_\_\_\_ Ft. from N. Line  
990 \_\_\_\_\_ Ft. from S. Line  
\_\_\_\_\_ Ft. from E. Line  
330 \_\_\_\_\_ Ft. from W. Line

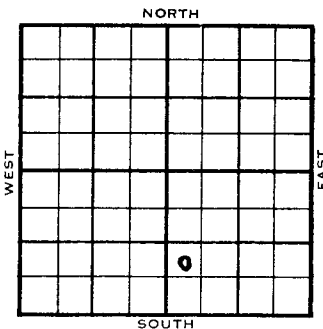

NW SW SE  
Frontier Oil-Support

1954	ELEVATION 2284'	REPORT
------	-----------------	--------

4/27 Spud 4-26-54  
8" @ 220'

5/5 rlg. 974'  
Anhy 1635', Heeb 3641', ' or 3661',  
KC 3679'  
D rlg. 3751'

5/12 Marm 3958 Cher 4094 Cong 4179  
DST 4170-98, 1 hr, 705' gassy oil  
150' M & GCO 900#-15"

5/19 Cored 4197-4232' Cored 4232-55  
Miss 4260 V 4274 Arb. 4360  
TD 4412' 5" @ 4411

6/9 Spud 4-26-54 D & A TD 4412'  
8" @ 220 Anhy 1635' Heeb 3641  
' or. 3661 KC 3679 Marm. 3958'  
Cherokee 4094' Cong. 4179'  
DST 4170-98 open 1 hr rec 705' gassy  
oil, 150' mud & GCO 900# Miss 4260  
Viola 4274' Arb. 4360' TD 4412'  
5" @ 4411 CO to 4305 24/4192-96  
B/6 GOPH 500 A S/1 1/2 BOPH 6 hr.  
S/36 BO 11 hr. sd-oil-frac.  
S/2 BOPH PB 4189 88/4175-88  
FU 500' oil 500 A S/1 BOPH 6 hr.  
CO to 4305 S/18 BO 16 hr. frac.  
S/1 BOPH PB 4150 40/4120-29

OVER

Section 11 Township 15 Range 22W **KANSAS**

Well No. #1 Coulson

Company Braden Drlg. & NACC

