


Kansas Pool Name Wildcat
 Map No. 76 Sec. 14 Twp. 15 R. 23W
 Well No. 1 Skagg
 Sohio Company

FIRST REPORT

Contractor

SE/C

SECTION PLAT

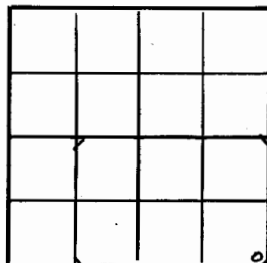

_____ Ft. from N. Line
330 Ft. from S. Line
330 Ft. from E. Line
 _____ Ft. from W. Line

Trego County

RECORD

Location _____
 Rig up _____
 Drilling and Remarks:
R U R
 Cased _____ in., _____ ft.
 Sand _____
 Gas _____
 Oil _____
 Total Depth _____

PRODUCTION

1st 24 hrs. Nat. _____
 1st 24 hrs. after shot _____
 Gas _____ Cu. Ft.
 Dry Hole _____
 Abandoned _____

Date

JUL 17 1946 19 S. J. LEWIS Scout


Kansas Pool Name Wildcat
 KANSAS
 Map No. 76 Sec. 14 Twp. 15 R. 23W
 Well No. 1 Skagg
 Sohio Company

ABANDONED

Contractor

SE/C

SECTION PLAT

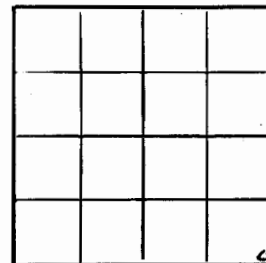

_____ Ft. from N. Line
330 Ft. from S. Line
330 Ft. from E. Line
 _____ Ft. from W. Line

Trego County

RECORD

Location _____
 Rig up _____
 Drilling and Remarks:
Loss 3728
Miss 4298
Viola 4454
Art 4583
 Cased _____ in., _____ ft.
 Sand _____
 Gas _____
 Oil _____
 Total Depth 4650

PRODUCTION

1st 24 hrs. Nat. _____
 1st 24 hrs. after shot _____
 Gas _____ Cu. Ft.
 Dry Hole _____
 Abandoned _____

Date

AUG 7 1946 19 S. J. LEWIS Scout

KANSAS

Trego County

Sec. 14 Twp. 15 R. 23W

Well No. #1 Skagg Farm

Sohio

Company


Wildcat

Ft. from N. Line

330 Ft. from S. Line

330 Ft. from E. Line

Ft. from W. Line

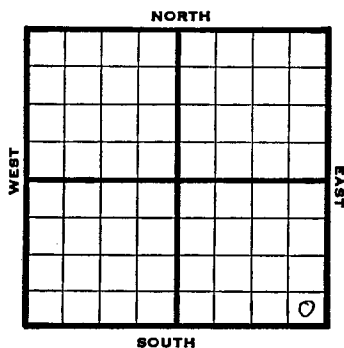

SE/c

1946 Elev. 2308

REPORT

7/17 RUR

7/23 8" @ 253

Anhy 1710'

Drlg 1743'

7/30 Drlg 3978'

8/7 Lans 3728

Miss 4298

Viola 4454

Arb. 4583

TD 4650'

COMPLETED

Trego County

Section 14 Township 15 Range 23W

Well No. #1 Skagg

Company Sohio

