

County **Trego** State **Kansas**
Sec. **5** (Bik. Twp.) **15** (Sur. Rge.) **24W** Map No.

Operator **Davis-Childs & Sterling**

Well No. **1** Farm **Jesse**

Elev. Location **NE NE NE**



330 Ft. From **N** Line **NE**

330 Ft. From **E** Line Quarter

1st. Report **JUN 13 1951**

Completion

Remarks

Spudding Date

Drlg. Data

Wildcat

LOCATION


J. E. TYRA

County **Trego** State **Kansas**
Sec. **5** (Bik. Twp.) **15** (Sur. Rge.) **24W** Map No.

Operator **Davis - Childs & Sterling Drlg.**

Well No. **1** Farm **Jesse**

Elev. **2309** Location **NE NE NE**

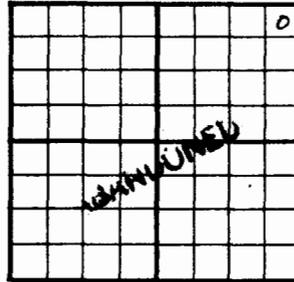

330 Ft. From **N** Line **NE**

330 Ft. From **E** Line Quarter

1st. Report

Completion **JUL 11 1951**

Remarks **Wildcat**

Sterling Drlg. - Contr

Spudding Date **6-14-51**

Drlg. Data **D & A TD 4243**

8" @ 345 Top. 3327 Heeb. 3585

Ians. 3629 Mar. 3977 Miss. 4201

Cong. 4181 TD 4243

D & A

J. E. TYRA

Trego

KANSAS

Sec. 5 Twp. 15 R. 24 W

Well No. # 1 Jesse Farm

Davis-Childs & Sterling Company

Sterling Drlg. - Contr. Contractor

Wildcat


330 Ft. from N. Line

Ft. from S. Line

330 Ft. from E. Line

Ft. from W. Line

NE NE NE

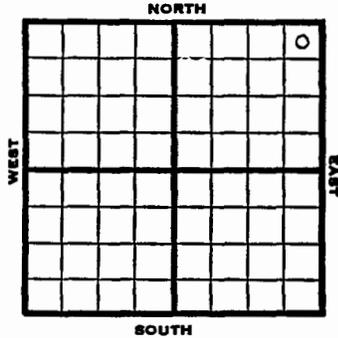

Trego


KANSAS

Section 5 Township 15 Range 24W

Well No. #1 Jesse

Company Davis-Childs & Sterling

NORTH

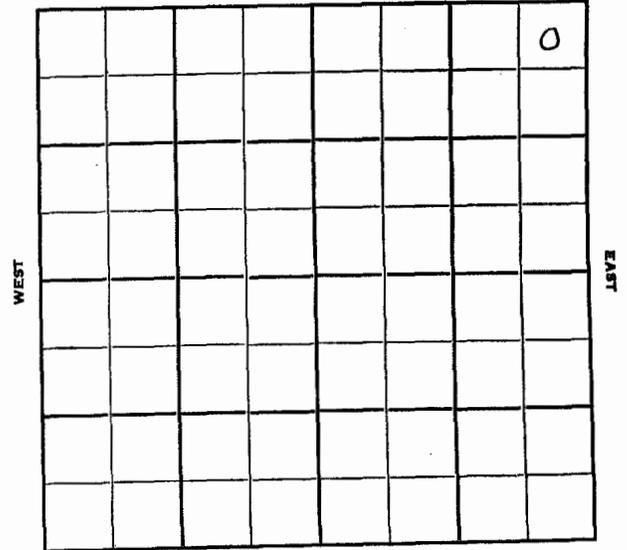

1951 Elev. 2309' REPORT

6/13 Location

7/11 Spud 6-14-51
D&A TD 4243
8" @ 345
Top 3327 Heeb. 3585
Lans. 3629 Mar. 3977
Miss 4201 Cong. 4181
TD 4243 D&A

ABANDONED