

Trego

KANSAS

Sec. 14 Twp. 15 R. 24W

Well No. #1 Hille Farm

Sohio & B&R Drlg. Company

B & R Drlg. Contractor
Wildcat


Ft. from N. Line

330 Ft. from S. Line

Ft. from E. Line

330 Ft. from W. Line

SW SW SE

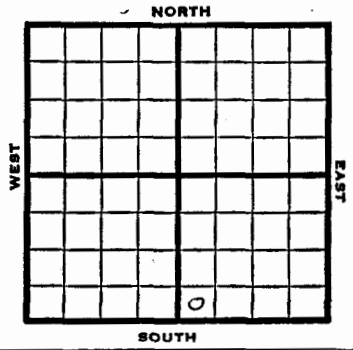


KANSAS

Section 14 Township 15 Range 24W

Well No. #1 Hille

Company Sohio & B & R Drlg.

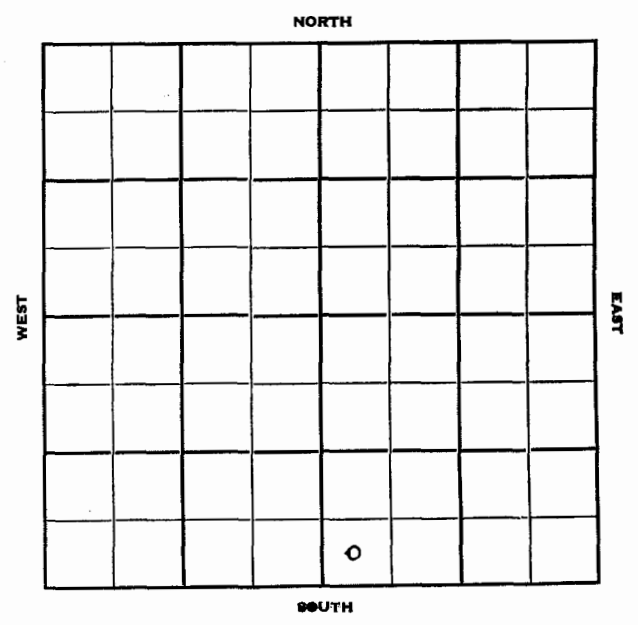

1951 Elev. 2320' **REPORT**

11/21 RUR
 12/19 Spud -
 D&A TD 4720
 8" @ 292
 Ians. 3704 Ft. Scott 4045
 Cong. 4274 Miss. 4302
 DST 4303-09 open 1 hr. Rec. 10'
 mud
 VIOLA 4600 Arb. 4715
 TD 4720
 D&A

ABANDONED