


KANSAS | Kansas Pool Name Wildcat
 Map No. 76 Sec. 23 Twp. 15 R. 24W
 Well No. 1 Hille
Republic Natural Gas Company
FIRST REPORT Contractor

SE SW

SECTION PLAT

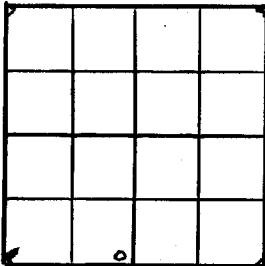

_____ Ft. from N. Line
330 Ft. from S. Line
330 Ft. from E. Line
 _____ Ft. from W. Line

Trego County

Location _____
 Rig up _____
 Drilling and Remarks:

10" @ 277

WOC

RECORD

Cased _____ in., _____ ft.
 Sand _____
 Gas _____
 Oil _____
 Total Depth _____

PRODUCTION

1st 24 hrs. Nat. _____
 1st 24 hrs. after shot _____
 Gas _____ Cu. Ft.
 Dry Hole _____
 Abandoned _____

Date


MAY 1 1946 19 S. J. LEWIS Scout

Hille Pool

Map No. 76 Sec. 23 Twp. 15 R. 24W
 Well No. 1 Hille
Republic Natural Gas Company
ABANDONED Contractor

SE SW

21,2389
SECTION PLAT

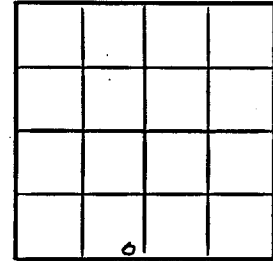

_____ Ft. from N. Line
330 Ft. from S. Line
330 Ft. from E. Line
 _____ Ft. from W. Line

Trego County

Location _____
 Rig up _____
 Drilling and Remarks:

11 in 4293
5" @ 4293

4213
73

RECORD

Cased _____ in., _____ ft.
 Sand _____
 Gas _____
 Oil _____
 Total Depth 4822

PRODUCTION

1st 24 hrs. Nat. _____
 1st 24 hrs. after shot _____
 Gas _____ Cu. Ft.
 Dry Hole _____
 Abandoned _____

Date

OCT 30 1946 19 S. J. LEWIS Scout

Sec. 23 Twp. 15 R. 24W

Well No. #1 Hille Farm

Republic Natural Gas Company


Wildcat

_____ Ft. from N. Line

330 Ft. from S. Line

830 Ft. from E. Line

_____ Ft. from W. Line

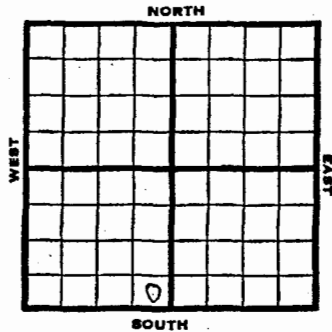

SE SW

1946	Elev. 2339'	REPORT
5/1	10" @ 277'	WOC
5/7	Drlg 2775'	
5/14	Abhy 1710	Drlg 3960'
5/21	Lans 3688	Cong 4262
	Miss 4293-95	TD No shows
	5" @ 4293,	RUST
5/29	" "	" "
6/5	" "	" "
6/12	" "	" "
6/18	" "	" "
6/26	Pump 75 oil	2% W in 21 hrs.
7/3	" "	" "
7/9	" "	" "
7/16	" "	" "
7/23	Pump 18 oil plus	90% W, 24 hrs.
7/30	" "	" "
8/6	" "	" "
8/13	TD 4322	PB 4319-750
	acid	
8/20	" "	" "
8/27	" "	" "
9/5	" "	" "
9/10	" "	" "
9/18	" "	" "

OVER

1946

9/24 TD 4322'
PB 4319-750 acid
10/1 " " "
10/8 " " "
10/15 " " "
10/22 " " "
10/30 Miss 4293'
5" @ 4293'
TD 4322'

ABANDONED

Section 23 Township 15 Range 24W

Well No. 1 Hille

Company Republic Natural Gas.

