

SIDE ONE

STATE CORPORATION COMMISSION OF KANSAS  
OIL & GAS CONSERVATION DIVISION  
WELL COMPLETION FORM  
ACO-1 WELL HISTORY  
DESCRIPTION OF WELL AND LEASE

Operator: License # 5663Name: Hess Oil CompanyAddress P.O. Box 1009City/State/Zip McPherson, KS 67460

Purchaser: \_\_\_\_\_

Operator Contact Person: Bryan HessPhone ( 316 ) 241-4640Contractor: Name: Mallard JV, Inc.License: #4958Wellsite Geologist: James C. Hess

Designate Type of Completion

☒ New Well ☐ Re-Entry ☐ Workover

☐ Oil ☐ SWD ☐ Temp. Abd.  
☐ Gas ☐ Inj ☐ Delayed Comp.  
☒ Dry ☐ Other (Core, Water Supply, etc.)

If ~~OWNO~~: old well info as follows:

Operator: \_\_\_\_\_

Well Name: \_\_\_\_\_

Comp. Date \_\_\_\_\_ Old Total Depth \_\_\_\_\_

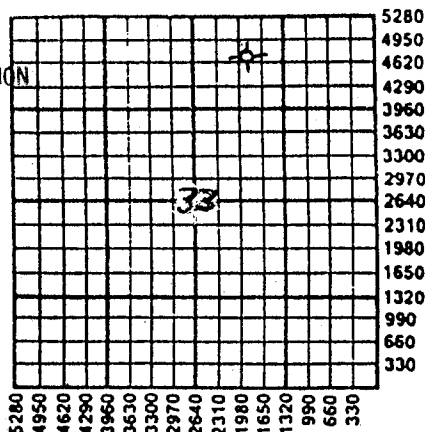
Drilling Method:

☒ Mud Rotary ☐ Air Rotary ☐ Cable4-24-91 4-30-91 4-30-91

Date Date Reached TD Completion Date

API NO. 15- 195-22,088County Tregoapprox. G NW NE Sec. 33 Twp. 15 Rge. 25 ☒ East West4780 Ft. North from Southeast Corner of Section1950 Ft. West from Southeast Corner of Section  
(NOTE: Locate well in section plat below.)Lease Name Basinger "B" Well # 2Field Name Basinger

Producing Formation \_\_\_\_\_

Elevation: Ground 2445' KB 2453'Total Depth 4399' PBTD \_\_\_\_\_

AIR DRY

Amount of Surface Pipe Set and Cemented at 212 FeetMultiple Stage Cementing Collar Used? ☐ Yes ☐ No

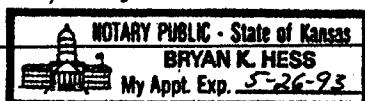
If yes, show depth set \_\_\_\_\_ Feet

If Alternate II completion, cement circulated from \_\_\_\_\_

feet depth to \_\_\_\_\_ w/ \_\_\_\_\_ sx cmt.

INSTRUCTIONS: This form shall be completed in triplicate and filed with the Kansas Corporation Commission, 200 Colorado Derby Building, Wichita, Kansas 67202, within 120 days of the spud date of any well. Rule 82-3-130, 82-3-107 and 82-3-106 apply. Information on side two of this form will be held confidential for a period of 12 months if requested in writing and submitted with the form. See rule 82-3-107 for confidentiality in excess of 12 months. One copy of all wireline logs and drillers time log shall be attached with this form. ALL CEMENTING TICKETS MUST BE ATTACHED. Submit CP-4 form with all plugged wells. Submit CP-111 form with all temporarily abandoned wells. Any recompletion, workover or conversion of a well requires filing of ACO-2 within 120 days from commencement date of such work.

All requirements of the statutes, rules and regulations promulgated to regulate the oil and gas industry have been fully complied with and the statements herein are complete and correct to the best of my knowledge.

Signature Bryan HessTitle Vice-Pres. Date 6-10-91Subscribed and sworn to before me this 10 day of June, 19 91.Notary Public Bryan K. HessDate Commission Expires 7

K.C.C. OFFICE USE ONLY

F ☐ Letter of Confidentiality Attached

C ☐ Wireline Log Received

C ☐ Drillers Timelog Received

Distribution

☐ KCC ☐ SWD/Rep ☐ NGPA

☒ KGS ☐ Plug ☒ Other (Specify)

Form ACO-1 (7-89)

**SIDE TWO**

Operator Name Hess Oil Company Lease Name Basinger "B" Well # 2  
☐ East County Trego  
 Sec. 33 Twp. 15 Rge. 25 ☒ West

**INSTRUCTIONS:** Show important tops and base of formations penetrated. Detail all cores. Report all drill stem tests giving interval tested, time tool open and closed, flowing and shut-in pressures, whether shut-in pressure reached static level, hydrostatic pressures, bottom hole temperature, fluid recovery, and flow rates if gas to surface during test. Attach extra sheet if more space is needed. Attach copy of log.

|   |   
|---|---|-----------|-------|---------|------------|-------|---------|---------|-------|---------|---------|-------|---------|-------------|-------|---------|-----------|-------|---------|----------|-------|---------|--------|-------|---------|------------|-------|---------|-------------------|-------|---------|-----|-------|---------|
| Drill Stem Tests Taken <input type="checkbox"/> Yes <input checked="" type="checkbox"/> No<br>(Attach Additional Sheets.)<br><br>Samples Sent to Geological Survey <input type="checkbox"/> Yes <input checked="" type="checkbox"/> No<br><br>Cores Taken <input type="checkbox"/> Yes <input checked="" type="checkbox"/> No<br><br>Electric Log Run <input type="checkbox"/> Yes <input checked="" type="checkbox"/> No<br>(Submit Copy.) | <p align="center"><b>Formation Description</b></p> <div style="display: flex; justify-content: space-between;"> <input type="checkbox"/> Log           <input checked="" type="checkbox"/> Sample         </div> <table style="width:100%; border-collapse: collapse;"> <tr><td>Anhydrite</td><td align="right">1893'</td><td align="right">(+ 560)</td></tr> <tr><td>Base Anhy.</td><td align="right">1929'</td><td align="right">(+ 524)</td></tr> <tr><td>Heebner</td><td align="right">3742'</td><td align="right">(-1289)</td></tr> <tr><td>Lansing</td><td align="right">3785'</td><td align="right">(-1332)</td></tr> <tr><td>Stark Shale</td><td align="right">4014'</td><td align="right">(-1561)</td></tr> <tr><td>Base K.C.</td><td align="right">4074'</td><td align="right">(-1621)</td></tr> <tr><td>Marmaton</td><td align="right">4116'</td><td align="right">(-1663)</td></tr> <tr><td>Pawnee</td><td align="right">4204'</td><td align="right">(-1751)</td></tr> <tr><td>Fort Scott</td><td align="right">4284'</td><td align="right">(-1829)</td></tr> <tr><td>Mississippi Dolo.</td><td align="right">4390'</td><td align="right">(-1937)</td></tr> <tr><td>RTD</td><td align="right">4399'</td><td align="right">(-1946)</td></tr> </table> | Anhydrite | 1893' | (+ 560) | Base Anhy. | 1929' | (+ 524) | Heebner | 3742' | (-1289) | Lansing | 3785' | (-1332) | Stark Shale | 4014' | (-1561) | Base K.C. | 4074' | (-1621) | Marmaton | 4116' | (-1663) | Pawnee | 4204' | (-1751) | Fort Scott | 4284' | (-1829) | Mississippi Dolo. | 4390' | (-1937) | RTD | 4399' | (-1946) |
| Anhydrite   | 1893'   | (+ 560)   |       |         
| Base Anhy.   | 1929'   | (+ 524)   |       |         
| Heebner   | 3742'   | (-1289)   |       |         
| Lansing   | 3785'   | (-1332)   |       |         
| Stark Shale   | 4014'   | (-1561)   |       |         
| Base K.C.   | 4074'   | (-1621)   |       |         
| Marmaton   | 4116'   | (-1663)   |       |         
| Pawnee   | 4204'   | (-1751)   |       |         
| Fort Scott   | 4284'   | (-1829)   |       |         
| Mississippi Dolo.   | 4390'   | (-1937)   |       |         
| RTD   | 4399'   | (-1946)   |       |         

| CASING RECORD <input type="checkbox"/> New <input checked="" type="checkbox"/> Used |   |                           |                 |                                                                    |                |              |                            |         |
|-------------------------------------------------------------------------------------|---|---------------------------|-----------------|--------------------------------------------------------------------|----------------|--------------|----------------------------|---------|
| Report all strings set-conductor, surface, intermediate, production, etc.           |   |                           |                 |                                                                    |                |              |                            |         |
| Purpose of String                                                                   | Size Hole Drilled   | Size Casing Set (In O.D.) | Weight Lbs./Ft. | Setting Depth                                                      | Type of Cement | # Sacks Used | Type and Percent Additives |         |
| Surface                                                                             | 12 1/4"   | 8 5/8"                    | 20#             | 212'                                                               | 60/40 poz      | 135sks       | 2%gel, 3%cc                |         |
|                                                                                     |   |                           |                 |                                                                    |                |              |                            |         |
| PERFORATION RECORD                                                                  |   |                           |                 | Acid, Fracture, Shot, Cement Squeeze Record                        |                |              |                            |         |
| Shots Per Foot                                                                      | Specify Footage of Each Interval Perforated   |                           |                 | (Amount and Kind of Material Used)                                 |                |              | Depth                      |         |
|                                                                                     |   |                           |                 |                                                                    |                |              |                            |         |
| TUBING RECORD                                                                       |   |                           |                 | Liner Run <input type="checkbox"/> Yes <input type="checkbox"/> No |                |              |                            |         |
| Size                                                                                | Set At   | Packer At                 |                 |                                                                    |                |              |                            |         |
|                                                                                     |   |                           |                 |                                                                    |                |              |                            |         |
| Date of First Production                                                            | Producing Method <input type="checkbox"/> Flowing <input type="checkbox"/> Pumping <input type="checkbox"/> Gas Lift <input type="checkbox"/> Other (Explain) |                           |                 |                                                                    |                |              |                            |         |
| Estimated Production Per 24 Hours                                                   | Oil   | Bbls.                     | Gas             | Mcf                                                                | Water          | Bbls.        | Gas-Oil Ratio              | Gravity |
|                                                                                     |   |                           |                 |                                                                    |                |              |                            |         |

Disposition of Gas: ☐ Vented ☐ Sold ☐ Used on Lease (If vented, submit ACO-18.)

**METHOD OF COMPLETION**

☐ Open Hole ☐ Perforation ☐ Dually Completed ☐ Commingled

☐ Other (Specify) \_\_\_\_\_

Production Interval \_\_\_\_\_

|                                                           |       |
|-----------------------------------------------------------|-------|
| MALLARD JV, INC.<br>P. O. BOX 1009<br>McPHERSON, KS 67460 |       |
| D R I L L E R S                                           | L O G |

JUN 12 1991

COPY

OPERATOR: Hess Oil Company  
P.O. Box 1009  
McPherson, KS 67460

WELL: Basinger "B" #2

API #: 15-195-22,088

COMMENCED: April 24, 1991

LOCATION: Approx. C NW NE

COMPLETED: April 30, 1991

4780 FT. FSL, 1950 FT FEL

TOTAL DEPTH: 4399 FT.

SEC. 33 TWP. 15 RGE. 25 W

ELEVATION: 2445 FT. GL, 2453 FT. KB

COUNTY: Trego

|                                       |                                        |
|---------------------------------------|----------------------------------------|
| STATUS: D & A - Mississippi Formation |                                        |
| Size Hole Drilled:                    | 12-1/4" x 215'                         |
| Surface Casing:                       | 8-5/8" x 20# x 202.02' (5 jts.)        |
| Set At:                               | 211.62'                                |
| Cement:                               | 135 sacks 60/40 Pozmix, 2% gel, 3% cc  |
| P.D.:                                 | 9:25 p.m. 4/24/91                      |
| Size Hole Drilled:                    | 7-7/8" x 4399'                         |
| Plugged Hole With:                    | 25 sacks @ 1900'                       |
|                                       | 100 sacks @ 875'                       |
|                                       | 40 sacks @ 250'                        |
|                                       | 10 sacks @ 40'                         |
|                                       | 15 sacks rathole                       |
|                                       | 10 sacks mousehole                     |
|                                       | 200 sacks total - 60/40 Pozmix, 6% gel |
| P.D.:                                 | 6:10 p.m. 4/30/91                      |
| Drill Stem Tests:                     | None                                   |
| Electric Log:                         | None                                   |

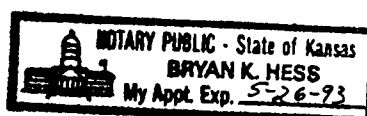
... CERTIFICATE ...

James H. Hess, Vice-President of Mallard JV, Inc., hereby certifies that this is a true and correct copy of the log of the following well, as reflected by the files of Mallard JV, Inc.: Basinger "B" #2

James H. Hess  
James H. Hess, Vice-President

STATE OF KANSAS )  
COUNTY OF McPHERSON ) ss.

Subscribed and sworn to before me this 13th day of May, 1991.



Bryan K. Hess  
Bryan K. Hess, Notary Public