

TYPE

AFFIDAVIT OF COMPLETION FORM

ACO-1 WELL HISTORY

SIDE ONE

35-15-26W Compt. *del*

(Rules 82-3-130 and 82-3-107)

This form shall be filed with the Kansas Corporation Commission, 200 Colorado Derby Building, Wichita, Kansas 67202, within ninety (90) days after the completion of a well, regardless of how the well was completed.

FOR INFORMATION REGARDING THE NUMBER OF COPIES TO BE FILED AND APPLICATIONS REQUIRING COPIES OF ACO-1 FORMS SEE PAGE TWO (2), SIDE TWO (2) OF THIS FORM.

F Letter requesting confidentiality attached.

C Attach ONE COPY of EACH wireline log run (i.e. electrical log, sonic log, gamma ray neutron log etc.)\*\*\*Check here if NO logs were run X.

PLEASE FILL IN ALL INFORMATION. IF NOT AVAILABLE, INDICATE. IF INFORMATION LATER BECOMES AVAILABLE, SUBMIT BY LETTER.

LICENSE # 6177 EXPIRATION DATE August 1984

OPERATOR Foxfire Exploration Inc. API NO. 15-063-20,063A

ADDRESS 10403 W. Colfax Ave. - 740 COUNTY Gove

Lakewood, Colorado 80215 FIELD

\*\* CONTACT PERSON D.C. Marchant PROD. FORMATION

PHONE (303)233-5898

PURCHASER LEASE Chapman

ADDRESS WELL NO. 3 OWWO

WELL LOCATION C SE NW

DRILLING Foxfire Drilling Company 1980 Ft. from N Line and

CONTRACTOR 10403 W. Colfax Ave. - 740 1980 Ft. from W Line of

ADDRESS Lakewood, Colorado 80215 the (Qtr.) SEC 35 TWP 15 RGE 26 (W)

PLUGGING Sun Oil Well Cementing

CONTRACTOR ADDRESS P.O. Box 69

Hays, Kansas

TOTAL DEPTH 1150' PBD

SPUD DATE 3/21/84 DATE COMPLETED 3/21/84

ELEV: GR 2549' DF KB 2556'


DRILLED WITH (CABLE) (ROTARY) (AIR) TOOLS.

DOCKET NO. OF DISPOSAL OR REPRESSURING WELL BEING USED TO DISPOSE OF WATER FROM THIS LEASE

Amount of surface pipe set and cemented 254' DV Tool Used? No

TYPE OF COMPLETION THIS AFFIDAVIT APPLIES TO: (Circle ONE) - Oil, Shut-in Gas, Gas, Dry Disposal, Injection, Temporarily Abandoned. If OWWO, indicate type of re-completion. Other completion. NGPA filing

WELL PLAT

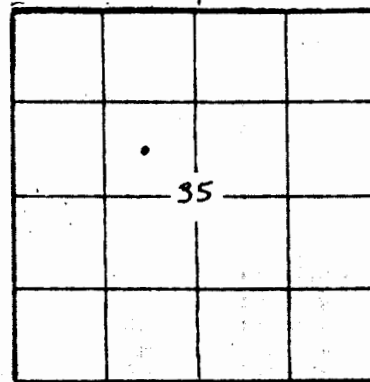

(Office Use Only)

KCC [checked] KGS [checked] SWD/REP PLG. NGPA

ALL REQUIREMENTS OF THE STATUTES, RULES AND REGULATIONS PROMULGATED TO REGULATE THE OIL AND GAS INDUSTRY HAVE BEEN FULLY COMPLIED WITH.

A F F I D A V I T

Roger Haag, being of lawful age, hereby certifies that:

I am the Affiant, and I am familiar with the contents of the foregoing Affidavit. The statements and allegations contained therein are true and correct.

SIDE TWO

ACO-1 WELL HISTORY

WDS-21-22

OPERATOR Fossil Exploration Inc. LEASE Chapman

SEC. 35 TWP. 15 RGE. 26

WELL IN WELL INFORMATION AS REQUIRED:

WELL NO. 3 OWVO

Show all important zones of permeability and contents thereof; cored intervals, and all drill-stem tests, including depth interval tested, cushion used, time tool open, flowing and shut-in pressures, and recoveries.

SHOW GEOLOGICAL MARKERS, LOGS RUN, OR OTHER DESCRIPTIVE INFORMATION.

FORMATION DESCRIPTION, CONTENTS, ETC.	TOP	BOTTOM	NAME	DEPTH
<input checked="" type="checkbox"/> Check if no Drill Stem Tests Run. <input checked="" type="checkbox"/> Check if samples sent to Geological Survey			No Logs Ran	
If additional space is needed use Page 2,				

Report of all strings set— surface, intermediate, production, etc. CASING RECORD (New) or (Used)

Purpose of string	Size hole drilled	Size casing set (in O.D.)	Weight lbs./ft.	Setting depth	Type cement	Socks	Type and percent additives
Surface		8-5/8"		254'			

LINER RECORD

PERFORATION RECORD

Top, ft.	Bottom, ft.	Socks cement	Shots per ft.	Size & type	Depth interval

TUBING RECORD

Size	Setting depth	Packer set at