

County **Gove** State **Kansas**

Sec. **22** (Blk. Twp.) **15** (Sur. Rge.) **29W** Map No.

Operator **Skiles Oil**

Well No. **1** Farm **Brune**

Elev. Location **SW SW SE**

330 Ft. From **S** Line **SE**

330 Ft. From **W** Line Quarter

1st. Report **MAY 14 1952**

Completion

Remarks **Lario & SP - DHV**
CRA - HM

Spudding Date

Drig. Data **Wildcat**

Location

J. G. McGEHEE

County **Gove** State **Kansas**

Sec. **22** (Blk. Twp.) **15** (Sur. Rge.) **29W** Map No.

Operator **Skiles Oil**

Well No. **1** Farm **Brune**

Elev. **2539** Location **SW SW SE**

330 Ft. From **S** Line **SE**

330 Ft. From **W** Line Quarter

1st. Report

Completion **JUN 4 1952**

Remarks **Wildcat**

Spudding Date **5-13-52**

Drig. Data **D & A TD 4487**

10" @ 140 Heeb. 3641 Lans. 3678

B KC 4018 Marm. 4041 Miss. 4296

TD 4487

D & A

J. G. McGEHEE

KANSAS

Sec. 22 Twp. 15 R. 29W

Well No. #1 Bruney Farm

Skiles Oil Company

Wildcat Contractor

Ft. from N. Line

330


Ft. from S. Line

Ft. from E. Line

330

Ft. from W. Line

SW SW SE

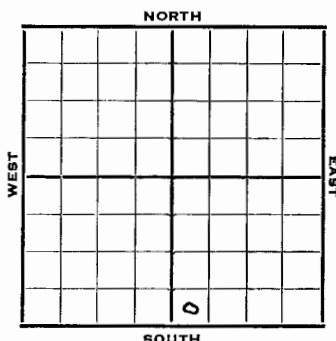


KANSAS

Section 22 Township 15 Range 29W

Well No. #1 Bruney

Company Skiles Oil

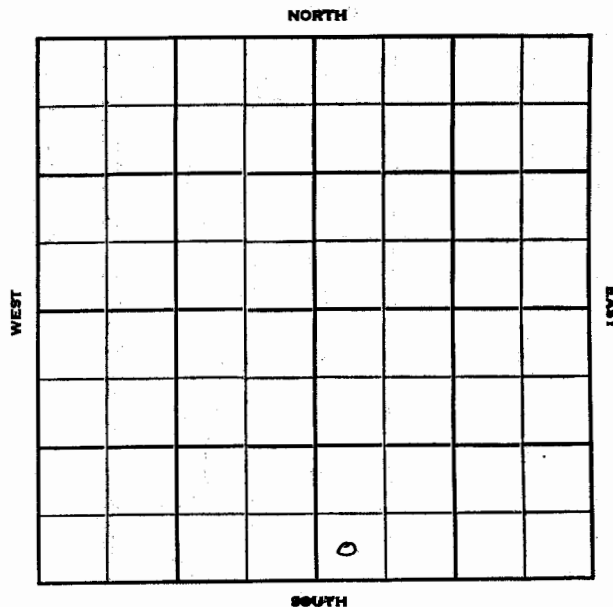

1952 Elev. 2539' REPORT

5/14 Location

5/21 10" @ 140'
Drlg. 3500'

5/28 Heeb. 3641 Lans. 3678
B KC 4018 Marm 4041
Drlg. 4316'

6/4 Spud 5-13-52
D&A TD 4487
10" @ 140 Heeb. 3641
Lans. 3678 BKC 4018
Marm. 4041 Miss 4296
TD 4487 D&A

ABANDONED