

County Saline				Elev.	
Sec. 13	Twp. 15	Rge. 3W			
Company Ben F. Brack Oil					
Farm Name Commerford No. 3					
TOPS	DEPTH	LOG	DATUM	Loc. in Sec.	
Anh.				NE SE NW	
TP.					
H.					
Tr.					
Dg.					
BL.					
L.				Geol.	
K.C.				Contr.	
B.K.C.					
Ce.					
C.					
M.				Pool	
M.				Mentor	
K.					
Mz.					
Ma.					
V.					
S.					
S.					
A.					
R.					
Pe.					
G.					
ID.				FIRST REPORT JUN 8 '55	
Date Comm. 6-2-55					
8" @ 246/250 drlg. 2100					

County Saline				Elev. 1261
Sec. 13	Twp. 15	Rge. 3W		
Company Ben F. Brack Oil				
Farm Name Commerford No. 3				
TOPS	DEPTH	LOG	DATUM	Loc. in Sec.
Anh.				NE SE NW
TP.				
H.				
Tr.				
Dg.				
BL.				
L.				Geol.
K.C.				Contr.
B.K.C.				
Ce.				
C.				
M.	2710		1449	
M.	Base 3000		1739	Pool
K.	Hunton 3127		1806	
Mz.	May sh 3176		1915	Mentor
Ma.	Dale 3250		1989	
V.	3287		2026	
S.	sh 3404		2140	
S.				
A.	3465		2204	
R.				
Pe.				
G.				
ID. 3475				ABANDONED
Date Comm. JUN 22 1955				
8" @ 246/250				
D & A				

Saline KANSAS

SEC.	TWP.	R.
13	15	3 W
WELL NO.		
# 3 Commerford		
COMPANY		
Ben F. Brack Oil		
CONTRACTOR		

Mentor


Ft. from N. Line

Ft. from S. Line

Ft. from E. Line

Ft. from W. Line

NE SE NW

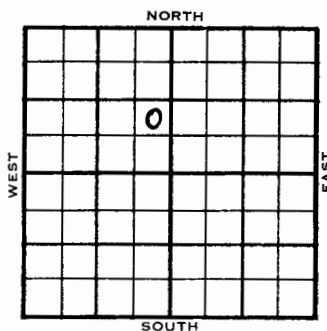

	ELEVATION	REPORT
1955	1261	
6/8	Comm. 6-2-55 8" @ 246/250 Drlg. 2100'	
6/22	M 2710, M. Base 3000, K Hunton 3127 Mz Maq sh 3176, Mq Dolo 3250 V 3287, S. Sh 3401, A 3465, TD 3475 8" @ 246/250 D & A	
		ABANDONED

DX-78

DX 78-1 Saline

KANSAS

Section 13 Township 15 Range 3W

Well No. #3 Commerford

Company Ben F. Brack Oil

