

Saline
15 R. KANSAS


Sec. 13 Twp. 15

Well No. #1 Muir Farm

Hollom et al Company

Contractor

Ft. from N. Line
990'
Ft. from S. Line
Ft. from E. Line
330'
Ft. from W. Line

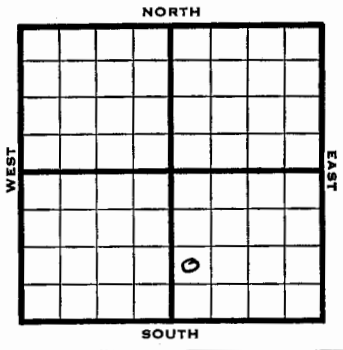

NW SW SE

1950 Elev 1267 REPORT

8/9 Spud 8-5-50
13" @ 120'
9-5/8" @ 290'
WOC

9/6 TD 3266
13" ● 120 9 5/8" ● 290
KC 2082 Cherokee shale 2573
Miss 2720 Kinderhook 2995
Hunton 3130 Maq 3186
Dol 3254
TD 3266 7" ● 3254 DST 3255-66 op 2 hr
rec 80' free oil 10' hocm
DP to 3266 FU 180' oil 16 hr
S/2 boph 1500 A Comp 35 bopd
Completed
COMPLETED

KANSAS Saline

Section 13 Township 15 Range 3-W

Well No. #1 Muir

Company Hollom et al

