

Saline KANSAS
Sec. 13 Twp. 15 R. 3W

Well No. #2 Commerford Farm

Ben F. Brack Company

Brack - Contr. Contractor
Mentor Pool


990' Ft. from N. Line

Ft. from S. Line

330' Ft. from E. Line

Ft. from W. Line

SE NE SW

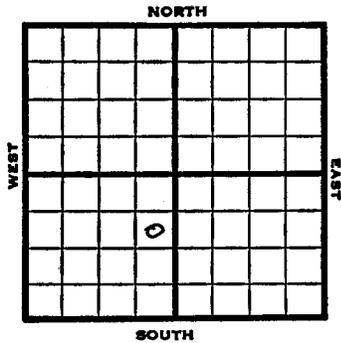


Saline KANSAS

Section 13 Township 15 Range 3 W

Well No. #2 Commerford

Company Ben F. Brack

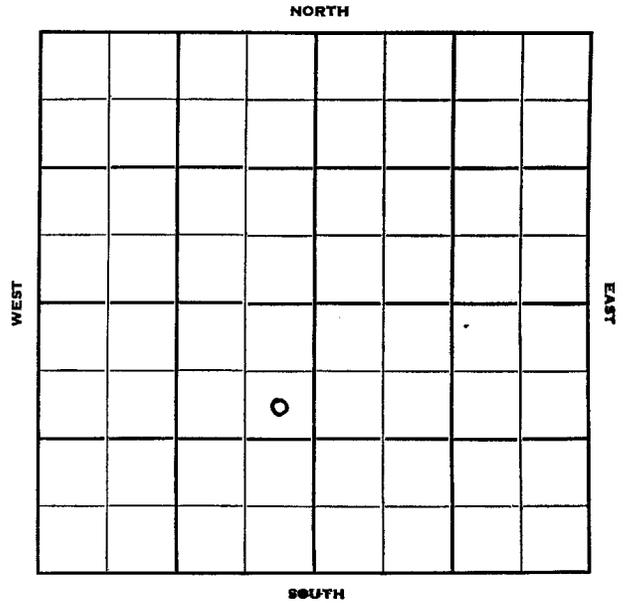

1951 Elev. 1264' REPORT

1/31 RUR

4/18 D & A TD 3265'
 8" @ 285' Miss. 2702' Kinderhook
 2990', Misenor 3131', Hunton 3137',
 Maq. 3173', Dol. 3247-50',
 5" @ 3247', TD 3255' 18/3249-55
 B/ 5 GOPH DD 3265' 3000 A
 B/ 6 GOPH & 80% water
 D & A

ABANDONED