


Pool Name Wildcat
 Map No. 48 Sec. 13 Twp. 15 R. 3W
 Well No. 1 Carlin

Mouser Drlg. etal Company

FIRST REPORT
NE SE SW Contractor

SECTION PLAT

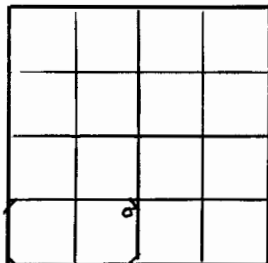

 Ft. from N. Line
990 Ft. from S. Line
330 Ft. from E. Line
 Ft. from W. Line

Saline

Location

Rig up

Drilling and Remarks:

8"-287

440

RECORD

Cased in., ft.

Sand

Gas

Oil

Total Depth

PRODUCTION

1st 24 hrs. Nat.

1st 24 hrs. after shot

Gas Cu. Ft.

Dry Hole

Abandoned

Date


NOV 15 1944 19 S. J. LEWIS Scout

Pool Name Wildcat
 Map No. 42 Sec. 13 Twp. 15 R. 3W
 Well No. 1 Carlin

Mouser Drlg. etal Company

COMPLETED
NE SE SW Contractor

SECTION PLAT

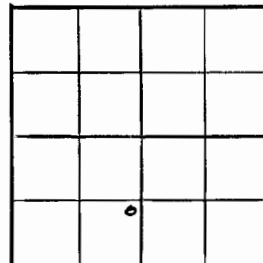

 Ft. from N. Line
990 Ft. from S. Line
330 Ft. from E. Line
 Ft. from W. Line

Saline

Location

Rig up

Drilling and Remarks:

Viola 8258.

5" C 3506

CR 43475.

Prod Viola

1500 acid

Pump 77 oil + 9% water

PT 352 lb

RECORD

Cased in., ft.

Sand

Gas

Oil

Total Depth 3506

PRODUCTION

1st 24 hrs. Nat.

1st 24 hrs. after shot

Gas Cu. Ft.

Dry Hole

Abandoned

Date

JAN 24 1945 19 S. J. LEWIS Scout

KANSAS Saline County

Sec. 13 Twp. 15 R. 3W

Well No. #1 Carlin Farm _____

Mouser Drlg. et al Company
Wildcat


_____ Ft. from N. Line

990 Ft. from S. Line

330 Ft. from E. Line

_____ Ft. from W. Line

NE SE SW Elev. 1263

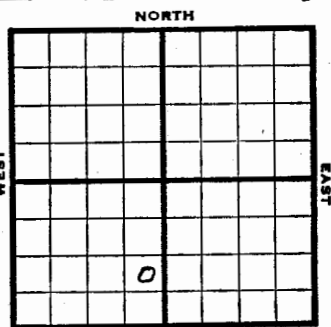

1944 REPORT

11/15 8" @ 287'
Drlg. 440'
11/24 Topeka 1695 Lans 2080 drlg. 2550
11/29 Topeak 1595 corrected Lans 2089
Miss 2724 Hunton 3121 Viola 3258
Arb. 3475 TD 3499 no shows
12/6 TD 3506'
To perf.
12/14 " "
12/21 50 shots 3256-3323
500 acid
12/29 1000 acid
Swb 4 oil per hour
no water

1945

1/3 " "

1/10 " "

1/17 " "

1/24 Viola 3258
5" @ 3506
Arb. 3475
Perf. Viola 1500 acid
TD 3506
Pump 77 oil plus 9% water. Pot.
Grav. 35.3

COMPLETED

KANSAS Saline County

Section 13 Township 15 Range 3W

Well No. #1 Carlin

Company Mouser Drlg. et al

