

Sec. 14 Twp. 15 R. 3W

Well No. #1 Millikin Farm

MURFIN Drlg.
Berry & Fick

Company

Berry & Fick Contractor
Wildcat

Ft. from N. Line


330 Ft. from S. Line

Ft. from E. Line

990 Ft. from W. Line

SE SW SW


Skelly \$2500

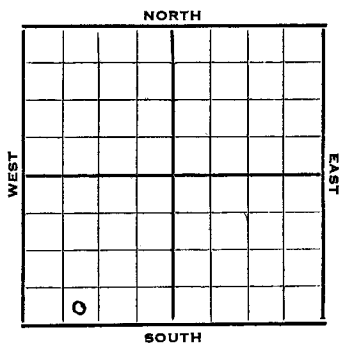

Section 14 Township 15 Range 3 W

Well No. # 1 Millikin

Company Berry & Fick MURFIN DRLG.

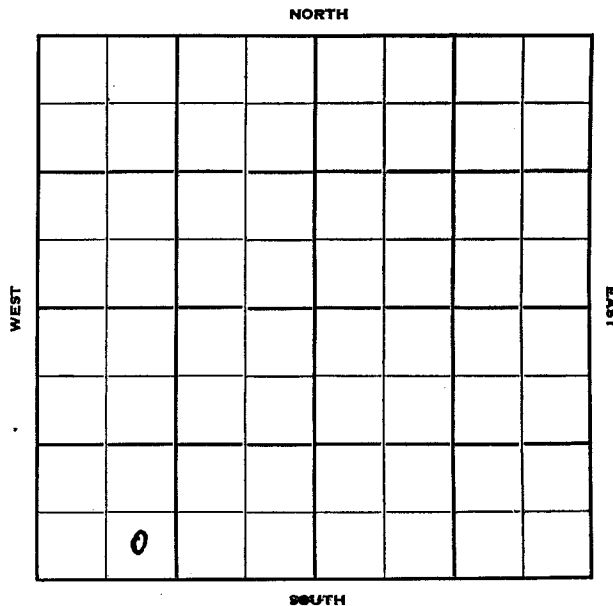

1952 Elev. 1262' REPORT

8/20 Location
8/27 " "
9/3 " "
9/10 8" @ 277
9/17 Lans. 2089' Miss 11 2722' KH 5007'
Drlg. 3104'
9/24 Spud 9-6-52
D&A TD 3517' 8" @ 277'
Lans. 2089 Miss 2722
Kh. 3007 Hunton 3186
Mzq. sh 3213 Maq. Dol. 3287
Viola 3331 Simp. 3443
Arb. 3507
TD 3517' D&A

ABANDONED