


County Saline State Kansas
 Sec. 17 (Blk. Twp.) 15 (Sur. Rge.) 3W Map No.

Operator N. V. Maybrier

Well No. 1 Farm Johnson

Elev. Location NE NW SE

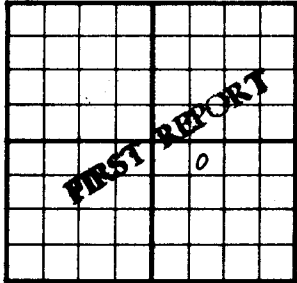

330 Ft. From N Line SE

990 Ft. From W Line Quarter

1st. Report JUL 18 1951

Completion

Remarks CRA - HIM

Victor Drlg. - Contr.

Spudding Date

Drlg. Data Semi Wildcat

R U R


J. E. TYRA

County Saline State Kansas
 Sec. 17 (Blk. Twp.) 15 (Sur. Rge.) 3W Map No.

Operator N. V. Maybrier

Well No. 1 Farm Johnson Perceval

Elev. 1296 Location NE NW SE

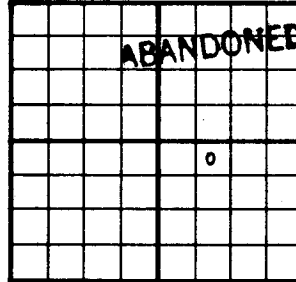

330 Ft. From N Line SE

990 Ft. From W Line Quarter

1st. Report

Completion AUG 15 1951

Remarks Semi Wildcat

Victor Drlg. - Contr.

Spudding Date 7-17-51

Drlg. Data D & A TD 3373

8" @ 428 stuck @ 1441 Skid 25' west

8" @ 342 Miss. 2797 Kh. 3095

Misnor 3236 Hunton 3247 Maq. sh. 3283

Maq. dol. 3346-73 TD

D & A

J. E. TYRA

Saline

KANSAS

Sec. 17 Twp. 15 R. 3 WWell No. # 1 Johnson Perceval Farm

N. V. Maybrier Company

Victor Drlg. Contractor

Semi-Wildcat

330 Ft. from N. Line


Ft. from S. Line

Ft. from E. Line

990 Ft. from W. Line

NE NW SE

CRA DHM

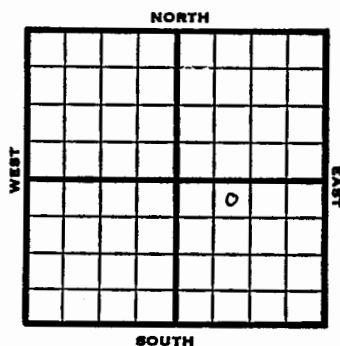

1951 Elev. 1296' REPORT

7/18 R U R

8/15 Spud 7-17-51

D & A TD 3373' 8" @ 428'

stuck @ 1441' Skid 25' west

8" @ 342' Miss 2797' KH. 3095'

Misenor 3236' Hunton 3247'

Maq. sh. 3283' Maq. dol. 3346-73' TD

D & A

ABANDONED

Saline

KANSAS

Section 17 Township 15 Range 3WWell No. 1 Johnson PercevalCompany N. V. Maybrier