

County Saline State Kansas
 Sec. 19 (Blk. 15) (Sur. SW) Map No.
 Operator Bay Pot
 Well No. 1 Farm Royce (C)
 Elev. _____ Location SE SE NW

FIRST REPORT									

330 Ft. From S Line NW
330 Ft. From E Line Quarter
 1st. Report JAN 16 1952
 Completion _____
 Remarks _____
Lindsley - Contr.
 Spudding Date 1-12-52

Drig. Data Smolan
8" @ 300 Drig. 530

J. E. TYRA

County Saline State Kansas
 Sec. 19 (Blk. 15) (Sur. SW) Map No.
 Operator Bay Pot.
 Well No. 1 Farm Royce "C"
 Elev. 1506 Location SE SE NW

COMPLETE									

330 Ft. From S Line NW
330 Ft. From E Line Quarter
 1st. Report _____
 Completion MAR 5 1952
 Remarks Smolan Pool
Lindsley - Contr.
 Spudding Date 1-12-52

Drig. Data Oil well TD 3408
8" @ 300 KC 2213 Dol. 3400 Kh. 3167
Miss. 3279 Hunton 3298 Mag. 3547
TD 3405 5" @ 3404 DD 3408 S/ 32 go
8 gw 1000 A S/ $\frac{1}{2}$ boph 10% water
Comp. 20 bopd 12% water

J. G. McGEHEE

Saline KANSAS

Sec. 19 Twp. 15 R. 3 W

Well No. # 1 Royce (C) Farm

Bay Pet Company

Lindsley Contractor


Ft. from N. Line

330 Ft. from S. Line

330 Ft. from E. Line

Ft. from W. Line

SE SE NW

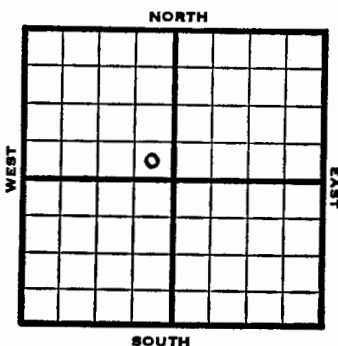


KANSAS

Section 19 Township 15 Range 3W

Well No. #1 Royce (C)

Company Bay Pet.

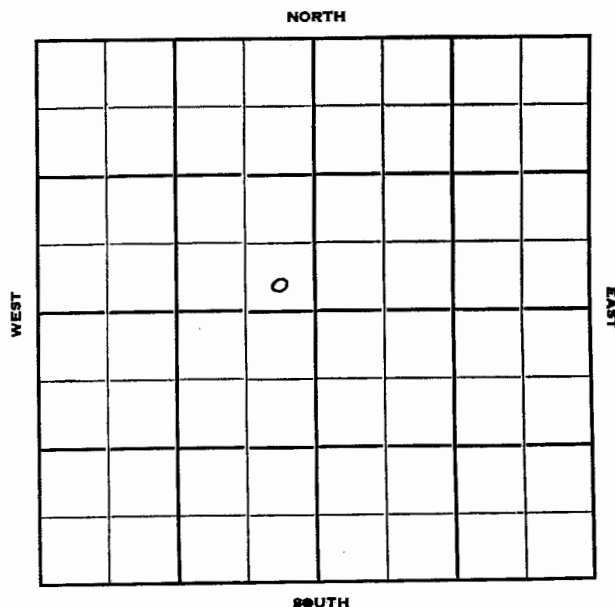

1952 Elev. 1306' REPORT

1/16 Spud 1-12-52

8" @ 300'

Drlg. 530'

2/6 POP

2/13 No report

2/20 POP

3/5 Spud 1-12-52

Oil well TD 3408' 8" @ 300

KC 2213' Dol. 3400' Kh. 3167'

Miss 3279' Hunton 3298' Maq. 3347'

TD 3405' 5" @ 3404' DD 3408'

S/32 GO 8 GW 1000 A S/1/2 BOPH

10% water.

Comp. 20 BOPD 12% water.

COMPLETED