


County Saline State Kansas
 Sec. 19 (Blk. 15 (Sur. 3W Map No.
 (Twp.) (Rge.)
 Operator Musgrove Pet.
 Well No. 4 Farm Richter "B"
 Elev. Location SW NE SW

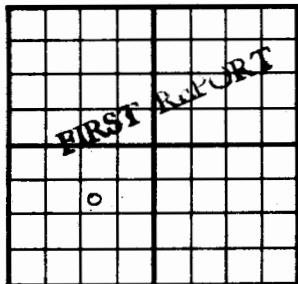

990 Ft. From N Line SW
990 Ft. From E Line Quarter

1st. Report AUG 1 1951

Completion

Remarks


Spudding Date 7-30-51

Drig. Data Smolan Pool

8" @ 358 WOC

J. E. TYRA

County Saline State Kansas
 Sec. 19 (Blk. 15 (Sur. 3W Map No.
 (Twp.) (Rge.)
 Operator Musgrove Pet.
 Well No. 4 Farm Richter "B"
 Elev. 1284 Location SW NE SW

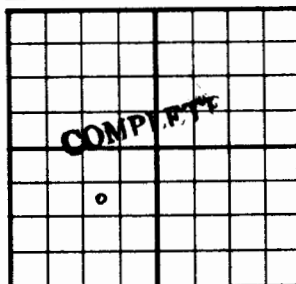

990 Ft. From N Line SW

990 Ft. From E Line Quarter

1st. Report

Completion SEP 5 1951

Remarks Smolan Pool

Spudding Date 7-30-51

Drig. Data Oil well TD 3399

8" @ 358 Viola 3396-09 5" @ 3396

TD 3399 S/ 4 boph 500 A S/ 5 boph

Comp. 572 bopd

J. E. TYRA

Saline

KANSAS

Sec. 19 Twp. 15 R. 3 W ✓

Well No. # 4 Richter "B" Farm

Musgrove Pet. Company

Contractor

Smolan Pool


990 Ft. from N. Line

Ft. from S. Line

990 Ft. from E. Line

Ft. from W. Line

SW NE SW

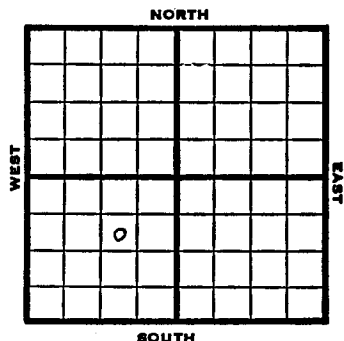


Saline KANSAS

Section 19 Township 15 Range 3W

Well No. 4 Richter "B"

Company Musgrove Pet.

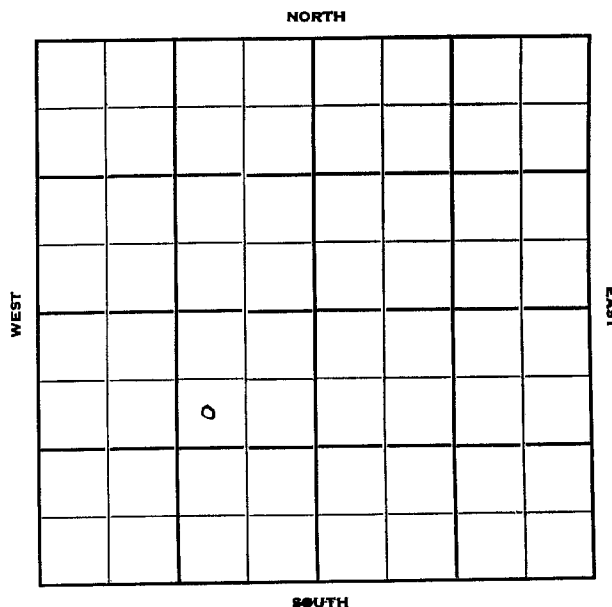

1951

Elev. 1284' REPORT

8/1

Spud 7-30-51
8" @ 358 WOC

9/5

Spud 7-30-51
Oil Well TD 3399
8" @ 358
Viola 3396-99 5" @ 3396
TD 3399 S/4 boph 500 A
S/5 boph Comp. 572 bopd

COMPLETED