


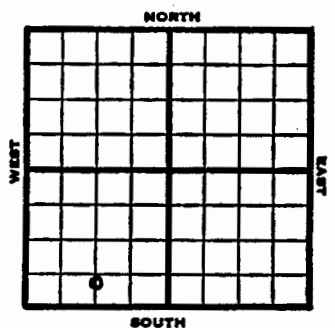

FORM 222-B Saline KANSAS ✓  
 Sec. 19 Twp. 15 R. 3W  
 Well No. #5 Richter Farm  
 Studnicka Oil et al Company  
 Carey Drlg. Contractor

\_\_\_\_\_ Ft. from N. Line  
 440 Ft. from S. Line  
 \_\_\_\_\_ Ft. from E. Line  
 1320 Ft. from W. Line  
 SW $\frac{1}{4}$  C S $\frac{1}{2}$  S $\frac{1}{2}$  SW



1953  
 2/18 Spudding Date 11/8/52  
 Oil Well ID 3403  
 8" @ 300 Miss 2842 Kh. 3171 Misener  
 3303 Hunton 3307 Maq. sh. 3327  
 Maq. dol. 3397 TD 3399 5" @ 3398  
 DD 3403 FU 540' oil 16 hr. ~~510~~  
 500A FU 600' oil 12 hr. S/26 bo  
 1 hr. s/22 bo 2nd hr. P/40 bo 5 hr.  
 Com. 159 bopd

**COMPLETED**

1952	Elev. 1287	REPORT
11/12	Spud 11-8-52 8" @ 300' Drlg. 530'	
11/20	Drlg. 2925'	
11/27	Miss 2842, KH 3171, Meisner 3303, Htn 3307, Mq sha 3327, Mq Dol 3397, TD 3399 5" @ 3398	
12/4	NR	
12/11	DD 3403 TD FW 540 Oil 16 Hrs.	
12/18	500A FU 600' oil 12 Hrs. S/26 BO 1 Hr. S/22 BO 2d Hr.	
12/25	" " " " "	
1/1	NR	
1/8	NR	
1/22	NR	
1/29	P/40 BO 5 hrs.	
2/5	NR	
2/12	NR	

**OVER**

FORM 51 25M 3-49 PETROL **Saline**

**KANSAS**

Section 19 Township 15 Range 3W

Well No. #5 Richter

Company Studnicka Oil et al

