



Saline

KANSAS

Sec. 19 Twp. 15 R. 3 W

Well No. # 3 Richter Farm

W. E. Studnicka Company

Musgrove Contractor

Smolan


990 Ft. from N. Line

Ft. from S. Line

Ft. from E. Line

330 Ft. from W. Line

SW NW SW

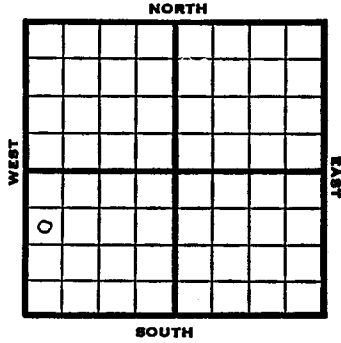


Saline

KANSAS

Section 19 Township 15 Range 3W

Well No. #3 Richter

Company W.E. Studnicka

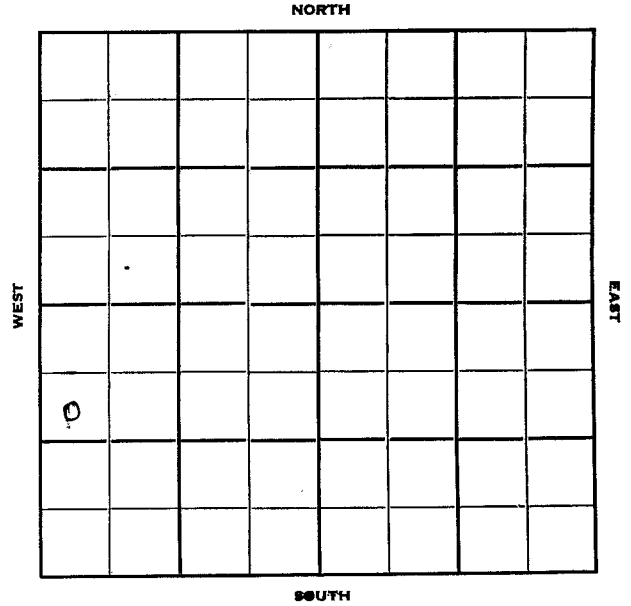

1951 Elev. 1287' REPORT

5/9 R U R

7/25 Spud 5-11-51  
 Oil well TD 3410' 8" @ 159  
 Viola 3407-10 5" @ 3407' TD 3410  
 B/1 BOPH 1000 A S/10 BOPH  
 Comp. 512 BOPD

COMPLETED