

County	Saline	State	Kansas	
Sec.	19 (Blk. Twp.)	15 (Sur. Rge.)	3W Map No.	
Operator	W. E. Studnica etal.	
Well No.	2	Farm	Richter	
Elev.	Location SW SW SW	
<table border="1"> <tr> <td>0</td> <td></td> <td></td> <td></td> <td></td> <td></td> <td></td> <td></td> <td></td> <td></td> </tr> <tr> <td></td> <td></td> <td></td> <td></td> <td></td> <td></td> <td></td> <td></td> <td></td> <td></td> </tr> <tr> <td></td> <td></td> <td></td> <td></td> <td></td> <td></td> <td></td> <td></td> <td></td> <td></td> </tr> <tr> <td></td> <td></td> <td></td> <td></td> <td></td> <td></td> <td></td> <td></td> <td></td> <td></td> </tr> <tr> <td></td> <td></td> <td></td> <td></td> <td></td> <td></td> <td></td> <td></td> <td></td> <td></td> </tr> <tr> <td></td> <td></td> <td></td> <td></td> <td></td> <td></td> <td></td> <td></td> <td></td> <td></td> </tr> <tr> <td></td> <td></td> <td></td> <td></td> <td></td> <td></td> <td></td> <td></td> <td></td> <td></td> </tr> <tr> <td></td> <td></td> <td></td> <td></td> <td></td> <td></td> <td></td> <td></td> <td></td> <td></td> </tr> <tr> <td></td> <td></td> <td></td> <td></td> <td></td> <td></td> <td></td> <td></td> <td></td> <td></td> </tr> <tr> <td></td> <td></td> <td></td> <td></td> <td></td> <td></td> <td></td> <td></td> <td></td> <td></td> </tr> </table>				0	
0	
365 Ft. From 3 Line SW	
485 Ft. From W Line Quarter	
1st. Report NOV 29 1950	
Completion	
Remarks	
Carey - Contr.	
Spudding Date	

Drig. Data

Location

J. E. TYRA

County	Saline	State	Kansas	
Sec.	19 (Blk. Twp.)	15 (Sur. Rge.)	3W Map No.	
Operator	W. E. Studnica etal.	
Well No.	2	Farm	Richter	
Elev.	1288	Location	SW SWSW	
<table border="1"> <tr> <td>0</td> <td></td> <td></td> <td></td> <td></td> <td></td> <td></td> <td></td> <td></td> <td></td> </tr> <tr> <td></td> <td></td> <td></td> <td></td> <td></td> <td></td> <td></td> <td></td> <td></td> <td></td> </tr> <tr> <td></td> <td></td> <td></td> <td></td> <td></td> <td></td> <td></td> <td></td> <td></td> <td></td> </tr> <tr> <td></td> <td></td> <td></td> <td></td> <td></td> <td></td> <td></td> <td></td> <td></td> <td></td> </tr> <tr> <td></td> <td></td> <td></td> <td></td> <td></td> <td></td> <td></td> <td></td> <td></td> <td></td> </tr> <tr> <td></td> <td></td> <td></td> <td></td> <td></td> <td></td> <td></td> <td></td> <td></td> <td></td> </tr> <tr> <td></td> <td></td> <td></td> <td></td> <td></td> <td></td> <td></td> <td></td> <td></td> <td></td> </tr> <tr> <td></td> <td></td> <td></td> <td></td> <td></td> <td></td> <td></td> <td></td> <td></td> <td></td> </tr> <tr> <td></td> <td></td> <td></td> <td></td> <td></td> <td></td> <td></td> <td></td> <td></td> <td></td> </tr> <tr> <td></td> <td></td> <td></td> <td></td> <td></td> <td></td> <td></td> <td></td> <td></td> <td></td> </tr> </table>				0	
0	
365 Ft. From S Line SW	
485 Ft. From W Line Quarter	
1st. Report	
Completion FEB 21 1951	
Remarks	
Carey - Contr.	
Spudding Date	

Drig. Data

Oil well TD 3409

8" @ 315 Miss. 2851 Kinderhook 3170

Misencr 3306 Hunton 3309 Maq. 3334

Dol. 3406 DST 3406-09 TD open $\frac{1}{2}$ hr.

Rec. 250' oil 200' ccm 5" @ 3406

FU 2675' oil 14 hr. S/ 7 boph

Comp. 191 bopd

J. E. TYRA

Saline KANSAS

Sec. 19 Twp. 15 R. 3W ✓

Well No. #2 Richter Farm

W. E. Studnica et al Company

Carey Contr. Contractor


Ft. from N. Line

365' Ft. from S. Line

Ft. from E. Line

485' Ft. from W. Line

SW SW SW

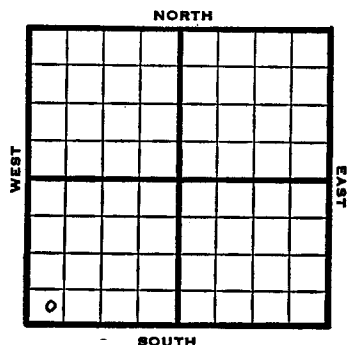


Saline KANSAS

Section 19 Township 15 Range 3W

Well No. #2 Richter

Company W. E. Studnica et al

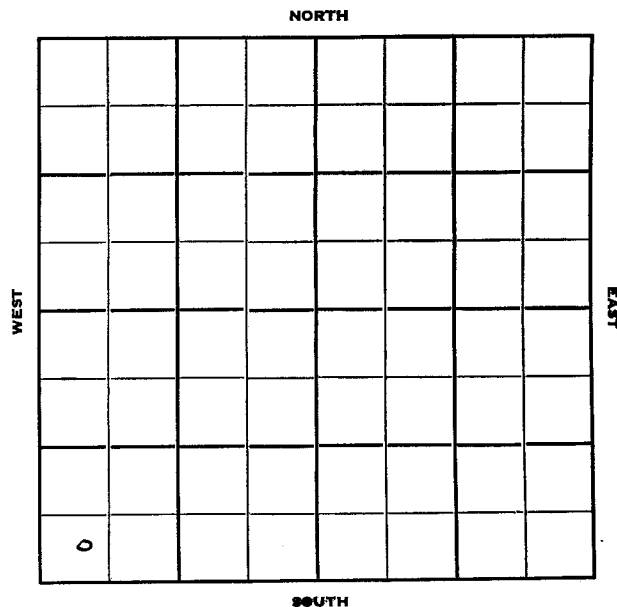

1950 Elev. 1288' REPORT

11/29 Location

1951
2/21 Oil well TD 3409
8" @315

Miss. 2851 Kinderhook 3170

Misnor 3306 Hunton 3309 Maq. 3334

Dol. 3406

DST 3406-09 TD open 1/2 hr. rec. 250'

oil 200' OCM

5" @3406

FU 2675' oil 14 hr. S/ 7 boph

Comp. 191 bopd

COMPLETED