

County **Saline** State **Kansas**
 Sec. **19** (Blk. Twp.) **15** (Sur. Rge.) **3W** Map No.
 Operator **W. E. Studnicha et al.**
 Well No. **1** Farm **Richter**
 Elev. _____ Location **SE SE SW**


Section **19** Township **15** Range **3W**
 Well No. **#1 Richter**
 Company **W.E. Studnicha et al**

330 Ft. From **S** Line **SW**
330 Ft. From **E** Line **Quarter**
 Ist. Report **SEP 27 1950**
 Completion _____
 Remarks _____
E. K. Carey - Contr.
 Spudding Date _____

Drig. Data **Wildeat**

Location

J. E. TYRA

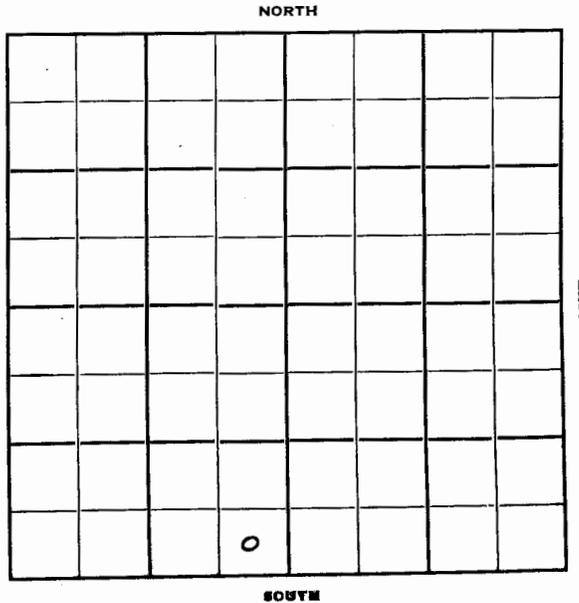

Sec. 19 Twp. 15 R. 3W


County Saline State Kansas

Sec. 19 (Bk. Twp.) 15 (Sur. Rge.) 3W Map No.

Operator W. E. Studnicha et al.

Well No. 1 Farm Richter

Elev. 1285 Location SE SE SW

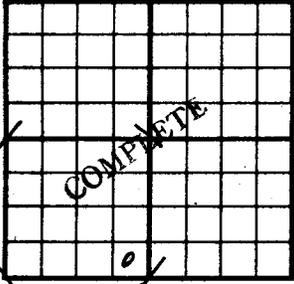

330 Ft. From S Line SW

330 Ft. From E Line Quarter

1st. Report

Completion DEC 1 1950

Remarks Wildcat

Carey - Contr.

Spudding Date 9-26-50

Drilg. Data Oil well TD 3391

8 5/8" @ 300 Miss. 2846 Hunton 3294

Viola 3385 DST 3386-91 TD open 45 min.

Rec. 30' ocm 60' hocm 120' clean oil

5" @ 3385 S/ 5 boph P/ 102 bopd

F/ 11 bopd Comp. 132 bopd

J. E. TYRA

Well No. #1 Richter Farm

W. E. Studnicha et al Company

E.K. Carey Contractor

Wildcat


Ft. from N. Line

330' Ft. from S. Line

330' Ft. from E. Line

Ft. from W. Line

SE SE SW

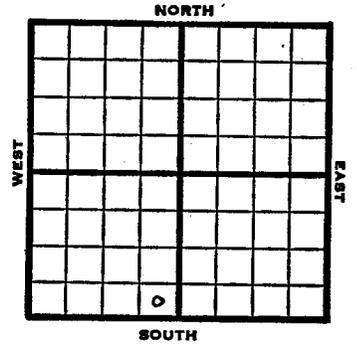

1950 Elv. 1285' REPORT

9/27 Location
12/13 Spud 9-26-50
Oil Well TD 3391
8-5/8" @ 300' Miss 2846'
Hunton 3294 Viola 3385
DST 3386-91 TD opn 45 min
Rec. 30' ocm 60' hocm 120' clean oil
5" @ 3385' S/5 boph P/102 bopd
F/11 bopd Comp. 132 bopd
COMPLETED