FORM 275 FOR SALE BY KANSAS BLUE PRINT CO.

County Saline State Kansas

Sec. 19 (Blk. Twp.) 15 (Sur. Rge.) 3W Map No.

Operator Westgate-Greenland

Well No. 2 Farm Larson

Elev. Location SW NW SE

FIRST REPORT

990 Ft. From N Line SE

330 Ft. From W Line Quarter

1st. Report DEC 20 1950

Completion

Remarks

Jackson Drlg. - Contr.

Spudding Date 12-16-50

Drlg. Data Smolan Pool

8" @ 298 drlg. 785

J. E. TYRA

FORM 275 FOR SALE BY KANSAS BLUE PRINT CO.

County Saline State Kansas

Sec. 19 (Blk. Twp.) 15 (Sur. Rge.) 3W Map No.

Operator Westgate-Greenland

Well No. 2 Farm Larson

Elev. 1279 Location SW NW SE

COMPLETE

990 Ft. From N Line SE

330 Ft. From W Line Quarter

1st. Report

Completion JAN 31 1951

Remarks Smolan Pool

Jackson Drlg. - Contr.

Spudding Date 12-16-50

Drlg. Data Oil well TD 3648

8" @ 298 Miss. 2835 B Miss. 3160

Hunton 3274 Viola 3377 DST 3388-99

open 1 hr. Rec. 35' hbcm Simp. 3534

Arb. 3628-48 5" @ 3432 SP 3404

36/ 3379-87 1000 A S/ ½ boph 3000 A

Comp. 15 bo 10 bwpd

J. E. TYRA

FORM 252-B
10M 11-50 PETROL

Saline KANSAS

Sec. 19 Twp. 15 R. 3W ✓

Well No. #2 Larson Farm

Westgate-Greenland Company

Jackson Drlg. - Contr. Contractor

Smolan Pool

990' Ft. from N. Line

Ft. from S. Line

Ft. from E. Line

330' Ft. from W. Line

SW NW SE

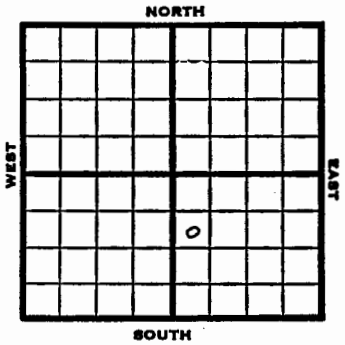

1950	Elev. 1279 REPORT
12/20	Spud 12-16-50 8" @ 298' Drlg. 785'
1951 1/31	Spud 12/16/50 Oil well TD 3648 8" @298 Miss 2835 B Miss 3160 Hunton 3274 Viola 3377 DST 3388-99 open 1 hr. Rec. 35' hocm Simp. 3534 Arb. 3628-48 5" @ 3432 SP 3404 36/ 3379-87 1000 A S/½ boph 3000 A Comp. 15 bo 10 bwpd

COMPLETED

FORM 51 25M 8-50 WESTERN

Saline KANSAS

Section 19 Township 15 Range 3W

Well No. #2 Larson
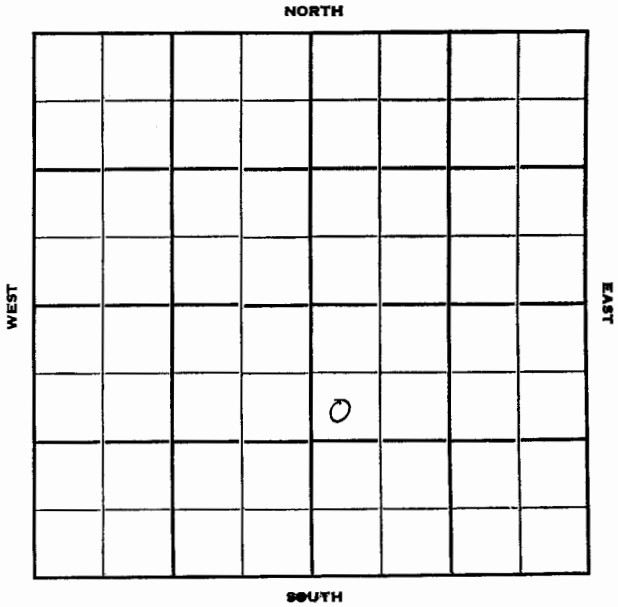
Company Westgate-Greenland