

County	Saline		State	Kansas	
Sec.	19	(Blk. Twp.)	15	(Sur. Rge.)	SW Map No.
Operator	Westgate-Greenland				
Well No.	1	Farm	Larson		
Elev.	Location		SW SW SE		
			330	Ft. From	S Line SE
			330	Ft. From	W Line Quarter
			1st. Report	NOV 1 1950	
			Completion		
			Remarks	Jackson Drlg. - Contr.	
			Spudding Date	10-28-50	

FIRST REPORT

Drlg. Data

8" @ 303 drlg. 310

J. E. TYRA

County	Saline		State	Kansas	
Sec.	19	(Blk. Twp.)	15	(Sur. Rge.)	3W Map No.
Operator	Westgate-Greenland				
Well No.	1	Farm	Larson		
Elev.	Location		SW SW SE		
			330	Ft. From	S Line SE
			330	Ft. From	W Line Quarter
			1st. Report		
			Completion	FEB 14 1951	
			Remarks	Smolan Pool	
			Remarks	Jackson Drlg. - Contr.	
			Spudding Date	10-28-50	

COMPLETE

Drlg. Data Oil well TD 3586

8" @ 303 Miss. 2839 Hunton 3284

Maq. 3320 Viola 3383 Simp. dol. 3532

Simp. sand 3536-40 TD 3586

Comp. 44 bopd 28% water

J. E. TYRA

KANSAS Saline

Sec. 19 Twp. 15 R. 3-W

Well No. #1 Larson Farm

Westgate-Greenland Company

Jackson Drlg. Contractor


Ft. from N. Line

330 Ft. from S. Line

Ft. from E. Line

330 Ft. from W. Line

SW SW SE

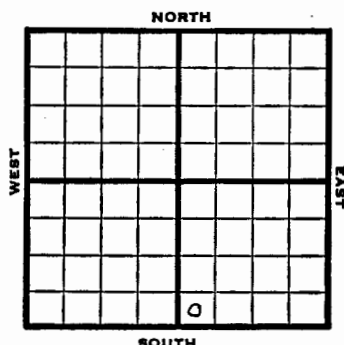

1950 Elev. 1284' REPORT

11/1 Spud 10-28-50
8" @ 303
Drlg 310

1951

2/14 Spud 10-28-50
Oil Well TD 3586
8" @ 303'
Miss 2839' Hunton 3284'
Maq. 3320' Viola 3383'
Simp. Dol. 3532'
Simp Sand 3536-40 TD 3586
Comp. 44 bopd 28% wtr.

COMPLETED

Saline

Section 19 Township 15 Range 3-W

Well No. #1 Larson

Company Westgate-Greenland

