

County	Saline	State	Kansas														
Sec.	19	(Blk. Twp.) 15	(Sur. Rge.) SW Map No.														
Operator	Shields Oil																
Well No.	1	Farm	Larson														
Elev.	1304	Location	SW SW NE														
<table border="1"> <tr> <td colspan="2">330 Ft. From S Line NE</td> </tr> <tr> <td colspan="2">330 Ft. From W Line Quarter</td> </tr> <tr> <td colspan="2">1st. Report AUG 1 1951</td> </tr> <tr> <td colspan="2">Completion</td> </tr> <tr> <td colspan="2">Remarks</td> </tr> <tr> <td colspan="2">Honaker Drlg. - Contr.</td> </tr> <tr> <td colspan="2">Spudding Date 7-29-51</td> </tr> </table>				330 Ft. From S Line NE		330 Ft. From W Line Quarter		1st. Report AUG 1 1951		Completion		Remarks		Honaker Drlg. - Contr.		Spudding Date 7-29-51	
330 Ft. From S Line NE																	
330 Ft. From W Line Quarter																	
1st. Report AUG 1 1951																	
Completion																	
Remarks																	
Honaker Drlg. - Contr.																	
Spudding Date 7-29-51																	
<table border="1"> <tr> <td colspan="2">FIRST REPORT</td> </tr> </table>				FIRST REPORT													
FIRST REPORT																	

Drlg. Data Smolan Pool

8" @ 315 WOC

J. E. TYRA

County	Saline	State	Kansas														
Sec.	19	(Blk. Twp.) 15	(Sur. Rge.) SW Map No.														
Operator	Shields Oil																
Well No.	1	Farm	Larson														
Elev.	1304	Location	SW SW NE														
<table border="1"> <tr> <td colspan="2">330 Ft. From S Line NE</td> </tr> <tr> <td colspan="2">330 Ft. From W Line Quarter</td> </tr> <tr> <td colspan="2">1st. Report</td> </tr> <tr> <td colspan="2">Completion OCT 17 1951</td> </tr> <tr> <td colspan="2">Remarks Smolan Pool</td> </tr> <tr> <td colspan="2">Honaker Drlg. - Contr.</td> </tr> <tr> <td colspan="2">Spudding Date 7-29-51</td> </tr> </table>				330 Ft. From S Line NE		330 Ft. From W Line Quarter		1st. Report		Completion OCT 17 1951		Remarks Smolan Pool		Honaker Drlg. - Contr.		Spudding Date 7-29-51	
330 Ft. From S Line NE																	
330 Ft. From W Line Quarter																	
1st. Report																	
Completion OCT 17 1951																	
Remarks Smolan Pool																	
Honaker Drlg. - Contr.																	
Spudding Date 7-29-51																	
<table border="1"> <tr> <td colspan="2">COMPLETE</td> </tr> </table>				COMPLETE													
COMPLETE																	

Drlg. Data Oil well TD 3407

8" @ 315 Miss. 2863 Kh. 3169

Misener 3308 Hunton 3316 Maq. sh. 3345

Maq. dol. 3403-05 5" @ 3403 TD 3407

500 A S/ $\frac{1}{2}$ boph 4 hr. 2500 A

S/ 1 boph 6 hr. Comp. 25 bopd 29% water

J. E. TYRA

Saline

KANSAS

Sec. 19 Twp. 15 R. 3 W ✓

Well No. # 1 Larson Farm

Shields Oil Company

Honaker Drlg. Contractor

Smolan Pool


Ft. from N. Line

330 Ft. from S. Line

Ft. from E. Line

330 Ft. from W. Line

SW SW NE

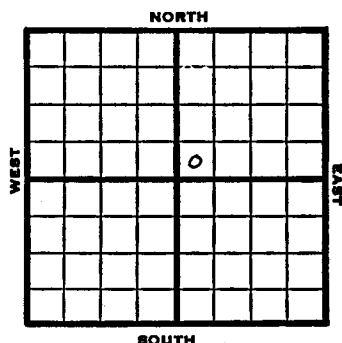


Saline KANSAS

Section 19 Township 15 Range 3W

Well No. 1 Larson

Company Shields Oil

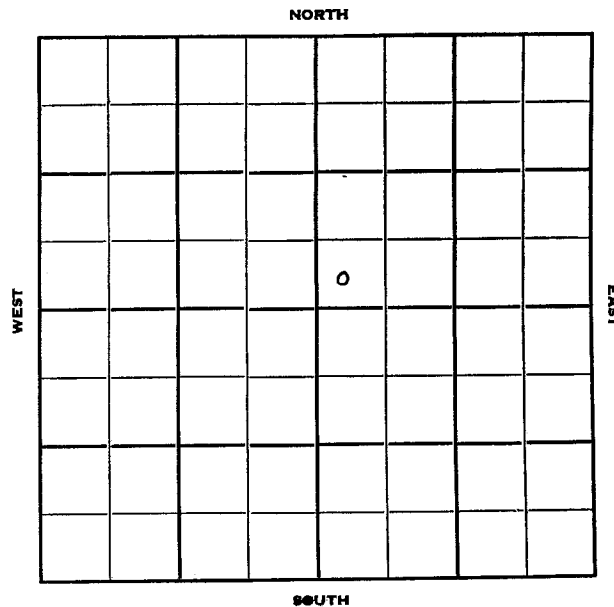

1951 Elev. 1304' REPORT

8/1 Spud 7-29-51
8" @ 315' WOC

8/17 Spud 7-29-51
Oil Well TD 3407
8" @ 315
Miss 2863
Kh 3169
Misener 3308
Hunton 3316
Maq. sh 3345
Maq. dol. 3403-05
5" @ 3403 TD 3407
500 A S/1/2 boph 4 hr
2500 A S/1 boph 6 hr
Comp. 25 bopd 29% wtr

COMPLETED