


County Saline State Kansas

Sec. 20 (1 Blk. / 15 Twp.) (3W Sur. / 3W Rge.) Map No.

Operator Sheldon Bros.

Well No. 1 Farm Holmquist

Elev. 1275 Location SE SE SE

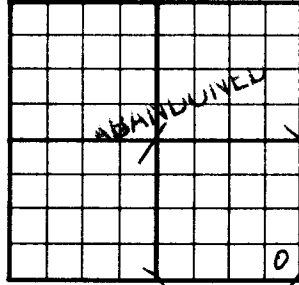

330 Ft. From S Line SE

330 Ft. From E Line Quarter

1st. Report

Completion JAN 31 1951

Remarks

Sterling Drlg. - Contr.

Spudding Date 1-13-51

Drlg. Data D & A TD 3421

13" @ 137 8" @ 310 Miss. 2772

Kinderhook 3106 Misenor 3240 Hunton

3246 Maq. 3264 Dol. 3325 Lime 3383

TD 3421 D & A

J. E. TYRA

Saline KANSAS ✓

Sec. 20 Twp. 15 R. 3W

Well No. #1 Holmquist Farm

Sheldon Bros. Company

Sterling Drlg.
Carey Drlg. - Contr. Contractor


Ft. from N. Line

330' Ft. from S. Line

330 Ft. from E. Line

330' Ft. from W. Line

~~SW SW SE~~
~~SE SE SE~~

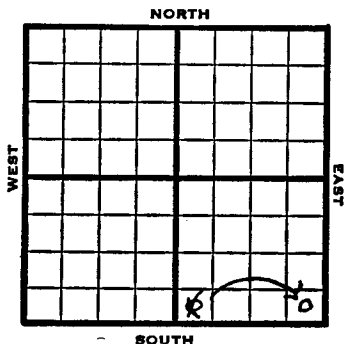


Saline KANSAS

Section 20 Township 15 Range 3W

Well No. #1 Holmquist

Company Sheldon Bros.

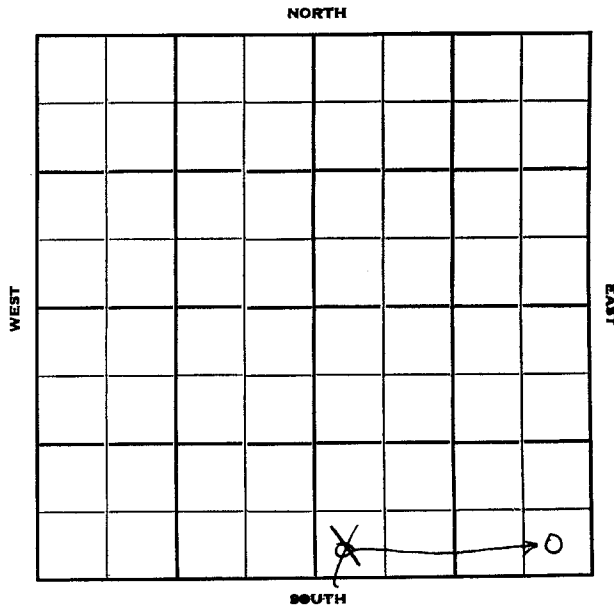

1950 Elev. 1279' REPORT

11/22 Cellar & Pits

1951

1/31

Spud 1/13/51

D & A TD 3421

13" @137

8" @310

Miss 2772 Kinderhook 3106 Misenor

3240 Hunton 3246 Maq. 3264

Dol. 3325 Lime 3383

TD 3421

D & A

ABANDONED