

County Saline State Kansas
 Sec. 24 (Blk. 15 (Sur. 3W Map No.
 Operator L. Hollam
 Well No. 1 Farm Nelson
 Elev. _____ Location SW NW NE

 990 Ft. From N Line NE
 330 Ft. From W Line Quarter
 Ist. Report OCT 25 1950
 Completion _____
 Remarks _____
Carey Drlg. - Contr.
 Spudding Date _____

Drlg. Data

Location

J. E. TYRA

County Saline State Kansas
 Sec. 24 (Blk. 15 (Sur. 3W Map No.
 Operator L. Hallam
 Well No. 1 Farm Nelson
 Elev. 1269 Location SW NW NE

 990 Ft. From N Line NE
 330 Ft. From W Line Quarter
 Ist. Report _____
 Completion NOV 8 1950
 Remarks Semi Wildcat
Carey Drlg. - Contr.
 Spudding Date 10-25-50

Drlg. Data

D & ATD 33418" C 244 Miss. line 2713 B Miss. line2992 Hunton 3128 Mag. sh. 3182Mag. dol. 3245 DST 3246-55 open 1 hr.Rec. 20' ocm 10' free oil Viola 3286SSO 3315-21 TD 3341 D & A

J. E. TYRA

Saline

KANSAS

Sec. 24 Twp. 15 R. 3W ✓

Well No. #1 Nelson Farm

L. Hollam Company

Carey Drlg. Contr. Contractor

990' Semi-Wildcat


Ft. from N. Line

Ft. from S. Line

Ft. from E. Line

330' Ft. from W. Line

SW NW NE

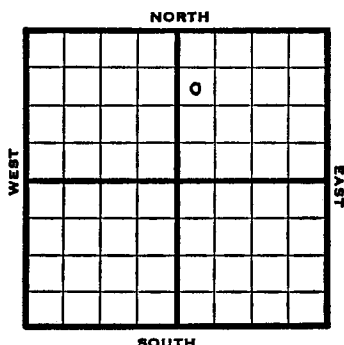


Saline KANSAS

Section 24 Township 15 Range 3W

Well No. #1 Nelson

Company L. Hollam

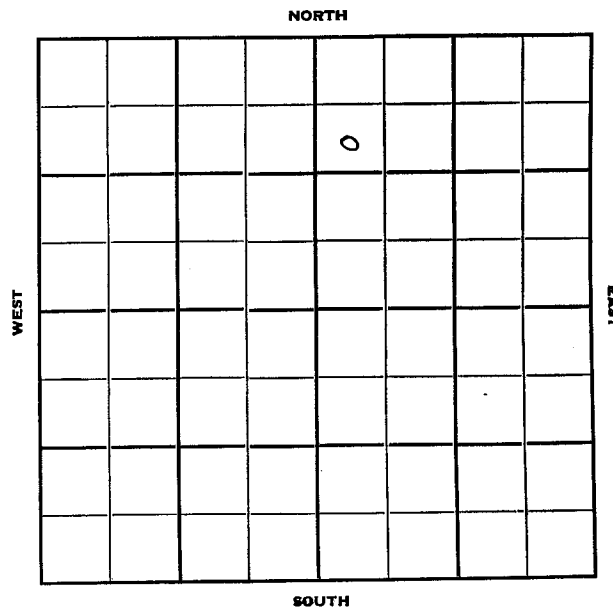

1950 Elev. 1269' **REPORT**

10/25 Location
11/8 Spud 10-25-50
D&A TD 3341
8" @ 244' Miss lime 2713'
B Miss Lime 2992' Hunton 3128'
Maq. sh 3182'
Maq dol. 3245'
DST 3246-55 opn 1 hr
Rec. 20' OC^M 10' free oil
Viola 3286' SSO 3315-21
TD 3341 D&A

ABANDONED