



Saline

KANSAS

Sec. 29 Twp. 15 R. 3W

Well No. #1 Holmquist Farm

Sterling Drlg. & Davis-Child Company

Sterling Drlg. Contractor

Salemberg Pool


Ft. from N. Line

330 Ft. from S. Line

Ft. from E. Line

330 Ft. from W. Line

SW SW SE

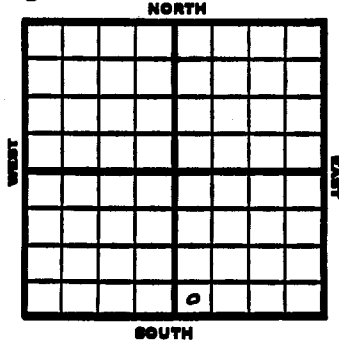

Saline


KANSAS

Section 29 Township 15 Range 3W

Well No. #1 Holmquist

Company Sterling Drlg. & Davis-Child

NORTH

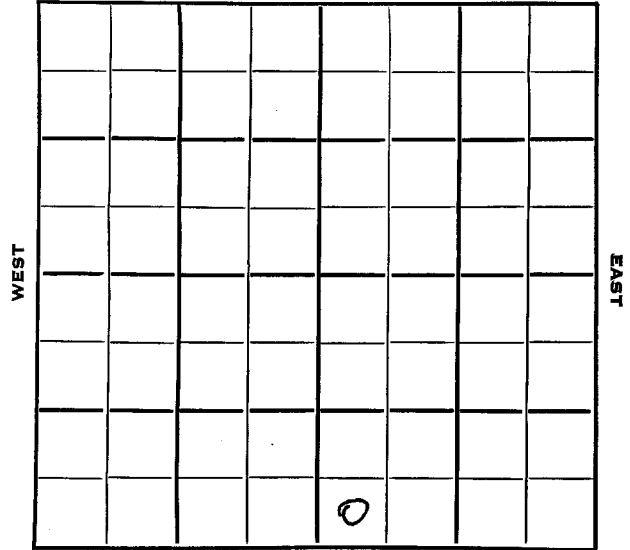

SOUTH

1953 Elev. 1291' REPORT

- 7/22 Spud 7-15-53  
13" @ 115'  
Drlg 2085'
- 7/29 Miss 2840, KH 3094, Meisner 3297,  
Htn 3299, Mq sha 3311, Mq dol 3375  
5" @ 3377  
RTD 3380'
- 8/5 CO 3380, 1000A, S/1 boph 1500A
- 8/12 NR
- 8/26 "
- 9/2 Spud 7-15-53  
Oil Well  
TD 3380'  
13" @ 115'  
Miss 2840, Kh 3094, Meisner  
3297, Hunton 3299, Maq. sh 3311,  
Maq. dol. 3375  
5" @ 3377  
TD 3380,  
CO to 3380, 1000A, S/1 boph, 1500A  
S/2 boph  
Comp. 50 bopd

COMPLETED