

County **Saline** State **Kansas**
 Sec. **30** (Blk. Twp.) **15** (Sur. Rge.) **3W** Map No.
 Operator **Max Gerkins**
 Well No. **1** Farm **Larson**


Section **30** Township **15** Range **3-W**
 Well No. **#1 Larson**
 Company **Max Gerkins**

Elev. _____ Location **NW NE NE**
330 Ft. From **N** Line **NE**
990 Ft. From **E** Line Quarter
 1st. Report **NOV 15 1950**
 Completion _____
 Remarks **Carey - Contr.**
 Spudding Date _____

Drig. Data **Smolan Pool**

R U R

J. E. TYRA

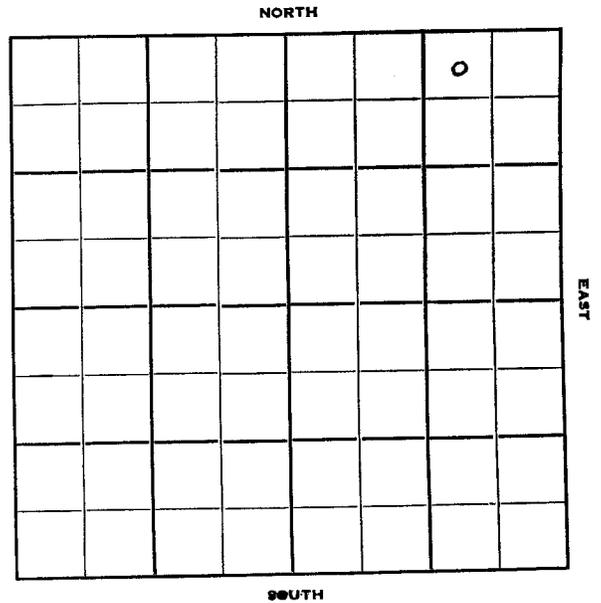

Saline

KANSAS

Sec. 30 Twp. 15 R. 3W


County Saline State Kansas

Sec. 30 (Blk. Twp.) 15 (Sur. Rge.) 3W Map No.

Operator Max Gerkins

Well No. 1 Farm Larson

Elev. 1282 Location NW NE NE

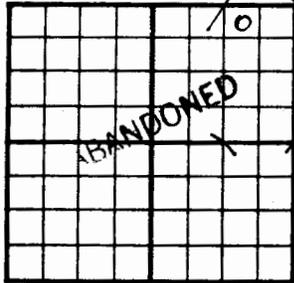

330 Ft. From N Line NE

990 Ft. From E Line Quarter

Ist. Report

Completion DEC 6 1950

Remarks Smolan Pool

Carey - Contr.

Spudding Date 11-14-50

Drig. Data D & A TD 3505

8 5/8" @ 260 Miss. 2836 Kinderhook 3172

Misener 3295 Hunton 3298 Maq. 3338

Dol. 3391 DST 3391-95 open 1 hr.

Rec. 30' socm Viola 3449 Dol. 3463

TD 3505 D & A

J. E. TYRA

Well No. #1 Larson Farm

Max Gerkins Company

Carey - Contr. Contractor

Smolan Pool


330' Ft. from N. Line

_____ Ft. from S. Line

990' Ft. from E. Line

_____ Ft. from W. Line

NW NE NE

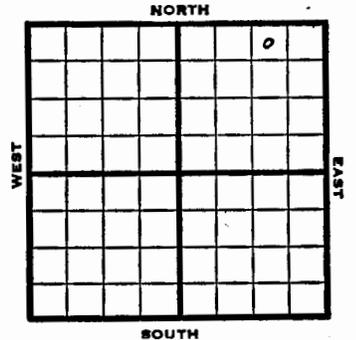

1950 Elev. 1282' REPORT

11/15 RUR
12/6 Spud 11-14-50
D&A TD 3505
8-5/8" @ 260' Miss 2836
Kinderhook 3172' Misener 3295'
Hunton 3298 Maq. 3338
Dol 3391'
DST 3391-95 opn 1 hr Rec. 30' socm
Viola 3449 Dol 3463 TD 3505
D&A **ABANDONED**